

CERTIFIED LAND CORNER RESTORATION



Index No. **G-6**

State of Wisconsin

County of Oneida } ss.

I Phillip T. Hansen do hereby certify that on the 19th day of March 1975, I found evidence of the WC-1/16 corner of Section 8 Township 36 North, Range 11 East, Fourth Principal Meridian, as described hereon; and that from this evidence I established a new monument and accessories as described hereon to perpetuate the original location of this corner.

Resident witnesses:

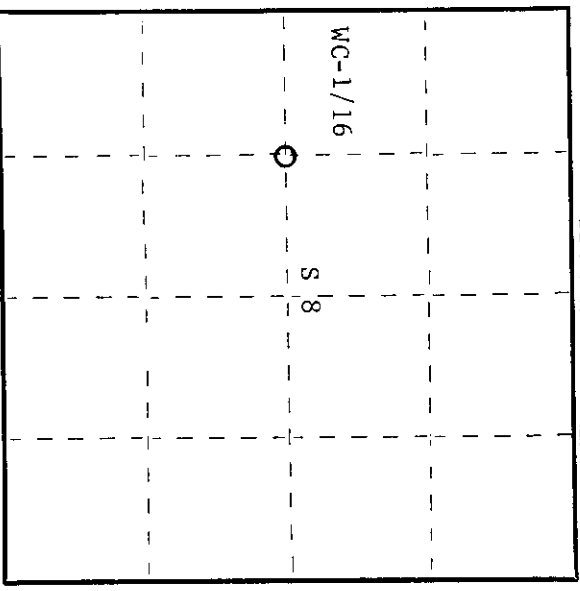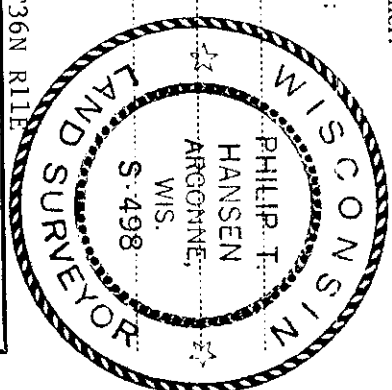

○ = Corner monument restored.

History of original corner establishment: Original corner established by D.H. Vaughan, County Surveyor, in 1904, from which birch 16" bears S53°E 37 chains. Corner restored by H.C. Lawrence, Registered Land Surveyor, in 1936. Recovered old post and stump of Vaughan's birch. Set new cedar post, from which yellow birch 12" bears S67°W 54 links, and sugar maple 9" bears N37°W 33 links. These are on the west side of road.

Description of corner evidence found: Recovered H.C. Lawrence's 4" cedar post, squared and scribed WC-1/16 S8, in fair condition. Also recovered a 1 1/2" O.D. iron pipe set beside wooden post. Recovered yellow birch 16" S70°W 54 links, scribed 1/16 NBT, and sugar maple N33°W 33.2 links, now just a dead stub about 8' high. Scribed WC-1/16 NBT.

Description of monument and accessories I established to perpetuate the original location of this corner. Replaced wooden post with 1 1/2" O.D. x 5' galvanized iron pipe stamped -

NBT's - sugar maple 8" N10°W 22.7 links, scribed 1/16 BT. Sugar maple 9" N12°E 31 links, scribed 1/16 BT. T36N R11E WC-1/16 S 8

CPT-1975

Dated at Rhineland, Wis., this 19th day of August, 1975.

Signature *Phillip T. Hansen* Title, Registered Land Surveyor Registration No. S-498 (County Surveyor, Registered Land Surveyor, or other duly authorized official)

Office of Register of Deeds, County of Oneida. I hereby certify that the within instrument was filed in this office for record on the 1st day of October, 1975 at 3:00 o'clock P.M.

*Toni Berger Tuelke* (Register Deeds)

By Deputy

0302801126