


CERTIFIED LAND CORNER RESTORATION


Index No. **F-7**

State of Wisconsin }
 County of Oneida } ss.

I Phillip T. Hansen, do hereby
 certify that on the 12th day
 of March 1975, I found
 evidence of the NC-1/16
 corner of Section 8
Township 36, North, Range
11 East, Fourth Principal Meridian,
 as described hereon; and that from this evidence
 I established a new monument and accessories
 as described hereon to perpetuate the original
 location of this corner.

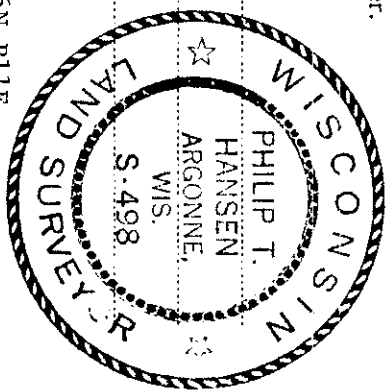

Resident witnesses:

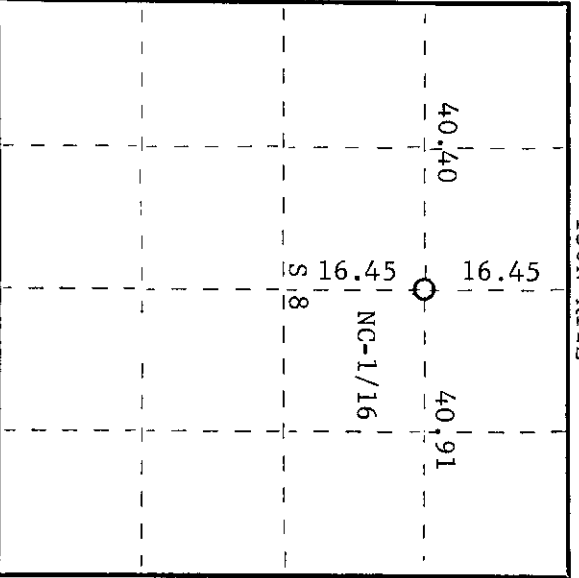

○ = Corner monument restored.

History of original corner establishment:

Original corner established by D.H. Vaughan, County Surveyor, in 1904.
 H.C. Lawrence, Registered Land Surveyor, unable to recover his corner in 1936, when he ran
 the E-W N-1/16 line. He intersected his corrected N-S ¼ line at 40.91 chains and set a
 cedar post 23 links offset south of line. This disagrees with Vaughan's chainage by
 28 links. Total difference in chainage of entire line was +10 links more than Vaughan's.

Description of corner evidence found:

Recovered 4" cedar post, squared and scribed S8NC-1/16S8, in poor condition. Stake was
 set in center of rock carron, with 1½" O.D. iron pipe set beside it.
 No trace of any BT. This is 23 links south of C/L of E-W road.

Description of monument and accessories I established to perpetuate the original location of this corner.
 Replaced wooden stake with 1½" O.D. x 50" iron pipe with two brass
 caps stamped -

NBT's - white birch 11" S6°E 36 links scribed 1/16 BT.
 White birch 9" N29°W 86 links scribed 1/16 BT.

W.C. 23 links N.
 CPI-1975

Dated at Rhineland, Wis., this 19th day of August, 1975.

Signature Phillip T. Hansen Title Registered Land Surveyor Registration No. S-498
 (County Surveyor, Registered Land Surveyor, or other duly authorized official)

Office of Register of Deeds, County of Oneida
 instrument was filed in this office for record on the 1st day of October, 1975
 at 3:00 o'clock P. M.

Doris George Fuchs
 (Register of Deeds)

By: _____ Deputy

0704801193