


CERTIFIED LAND CORNER RESTORATION

Index No. **5-12**

State of Wisconsin }
 County of Oneida } ss.

I Philip T. Hansen do hereby
 certify that on the 31st day
 of January, 1975, I found
 evidence of the E-1/16
 corner of Section 9-16
 Township 36 North, Range
 11 East, Fourth Principal Meridian,
 as described hereon; and that from this evidence
 I established a new monument and accessories
 as described hereon to perpetuate the original
 location of this corner.

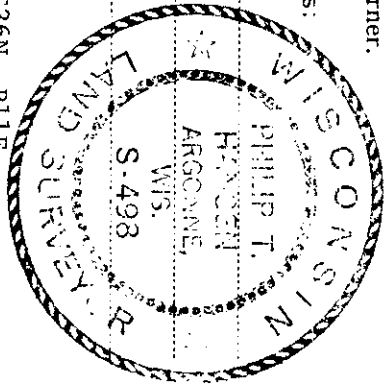

Resident witnesses:

History of original corner establishment:
 Corner established by H.C. Lawrence, Registered Land Surveyor, during his retracement
 survey of 1946.
 Corner set at equidistant between Section Corner and 1/4 line at 24.03 chains. Corrected
 bearing of line N86°26'W.


Description of corner evidence found:
 Recovered H.C. Lawrence's 4" cedar post, squared and scribed E-1/16 S9; E-1/16 S16 in
 poor condition. Rock carron piled around cedar post.

Recovered BT. White birch 8" S49½W 27 links scribed S16 BT
 No trace of - White birch 8" N69E

Description of monument and accessories I established to perpetuate the original location of this corner.
 Replaced wood stake with 1-1/4" O.D. x 5' galvanized iron pipe with brass cap
 stamped -

NBT - sugar maple 9" N28°W 37.5 links scribed 1/16 BT

S498
 T36N, R11E
 S 9
 E-1/16
 S 16
 CPI-1975

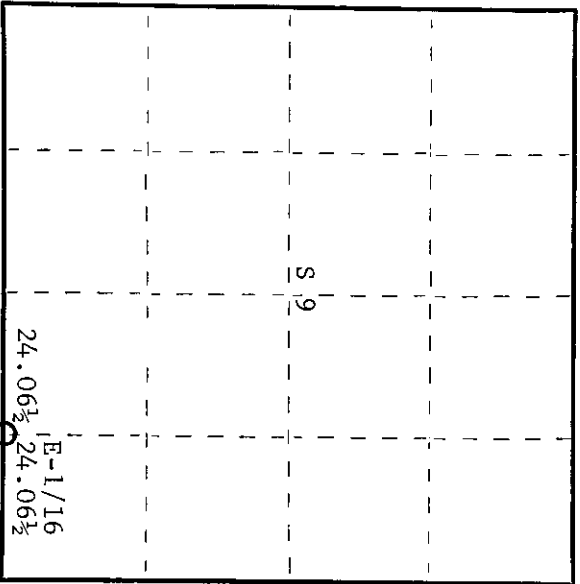

○ = Corner monument restored.

Dated at Rhinelander, Wis., this 16th day of June, 1975.

Signature *Philip T. Hansen* Title Registered Land Surveyor Registration No. S-498
 (County Surveyor, Registered Land Surveyor, or other duly authorized official)

Office of Register of Deeds, County of Oneida, at 300 o'clock P.M. I hereby certify that the within instrument was filed in this office for record on the 1st day of October, 1975.

Doris Verage Kueln
 (Register of Deeds)

By: Deputy

0100601193