



CERTIFIED LAND CORNER RESTORATION

Index No. H-13

State of Wisconsin }
 County of Oneida } ss.

I Philip T. Hansen, do hereby certify that on the 17th day of January, 1975, I found evidence of the S-1/16 corner of Sections 9 and 10 Township 36, North, Range 11 East, Fourth Principal Meridian, as described hereon; and that from this evidence I established a new monument and accessories as described hereon to perpetuate the original location of this corner.

Resident witnesses:

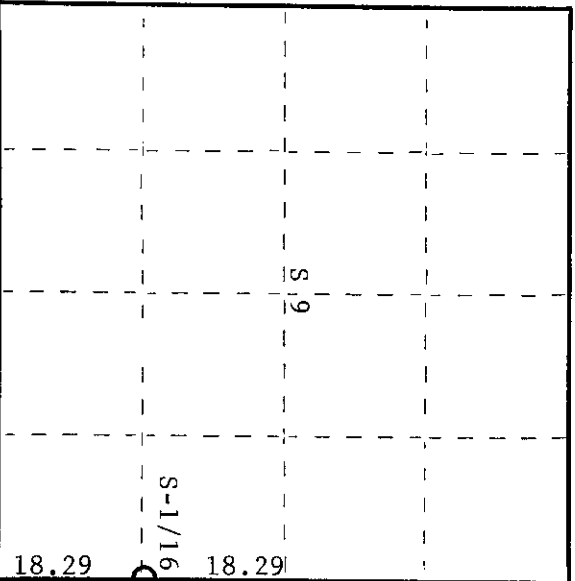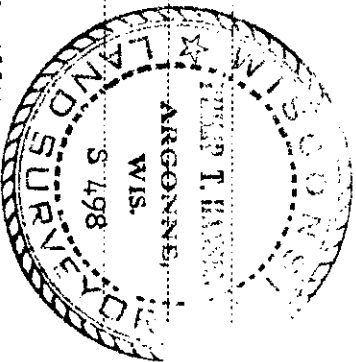

History of original corner establishment:

Original corner set by H.C. Lawrence, Registered Land Surveyor, during his retracement survey in 1952.

His notes state he ran South from the E-1/4 post set by D.H. Vaughan, County Surveyor, and remonumented by himself to intersect the corner of Sec. 9-10-15-16 at a point 27 lks. East of the corner at distance of 36.58 chains.

He set a 4" cedar post 13-1/2 lks. West at right angles and 18.19 chains intermediate and made BT's viz - Hemlock 12" N16 1/2 W 56 lks.; Maple 18" N88 1/2 W 21-1/2 lks.

Description of corner evidence found:

Recovered H.C. Lawrence's 4" cedar post, squared and scribed S10 S-1/16, S9 S-1/16 in good condition.

Recovered BT Hemlock 12" N16 1/2 W 56 lks. in good condition scribed 1/16 BT.

Recovered BT Sugar maple 18" N88 1/2 W 21 1/2 lks., green but badly scarred, scribed BT.

Description of monument and accessories I established to perpetuate the original location of this corner.

Set new 1-1/4" O.D. x 5' iron pipe with 2" brass cap stamped -

New BT. Sugar maple 11" N51 0 E 436 lks. Scribed 1/16 BT

S498
 T36N, R11E
 S9 | S10
 S-1/16
 CPT-1974

Dated at Rhineland, Wis., this 16th day of June, 19 75.

Signature Philip T. Hansen, Title Registered Land Surveyor, Registration No. S-498
 (County Surveyor, Registered Land Surveyor, or other duly authorized official)

Office of Register of Deeds, County of Oneida, I do hereby certify that the within instrument was filed in this office for record on the 1st day of October, 19 75 at 3:00 o'clock P. M.

Doris Savage Kuehn
 (Register of Deeds)

By: _____ Deputy

2611091000