

CERTIFIED LAND CORNER RESTORATION


Index No. H-12

State of Wisconsin }
County of Oneida } ss.


I Phillip T. Hansen, do hereby certify that on the 30th day of January, 1975, I found evidence of the SE-1/16 corner of Section 9 Township 36 North, Range 11 E, Fourth Principal Meridian,

as described hereon; and that from this evidence I established a new monument and accessories as described hereon to perpetuate the original location of this corner.

Resident witnesses:

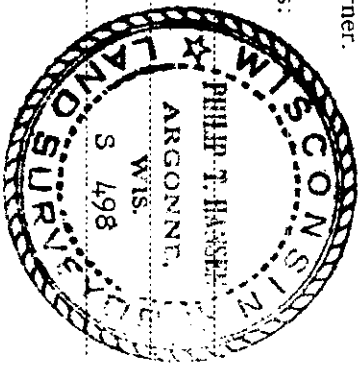

T36N R11E

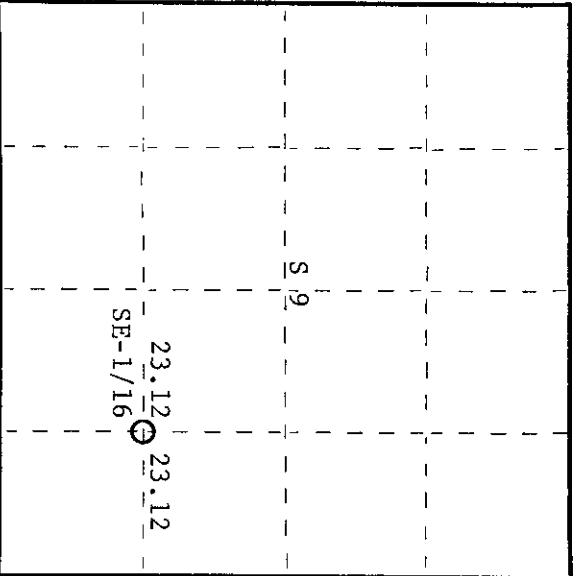

○ = Corner monument restored.

CERTIFIED LAND CORNER RESTORATION

History of original corner establishment:

Corner established by H.C. Lawrence, Registered Land Surveyor, during his retracement and subdivision survey of 1946. From established SC-1/16 he ran a random line S87°10'E and intersect 1/4-1/4 line at 23.12. Set 4" cedar post for SE-1/16 corner, equidistant bearing of corrected line, S85°06'E.

BT's - Maple 12" N67°½W 47 links
Black ash 10" N11E 31½ links

Description of corner evidence found:

Recovered 4" cedar post, squared and scribed SE-1/16 S9, SE-1/16 S9 in good condition.
Recovered - Maple 12" N67½°W 47 links scribed SE-1/16 BT
Black ash 10" N11°E 31½ links scribed SE-1/16 BT.

Description of monument and accessories I established to perpetuate the original location of this corner.

Replaced wooden stake with 1-1/4"OD x 5' iron pipe 2" brass cap stamped -

No new BT's.

S498
T36N R11E
SE-1/16

GPI-1975

Dated at Rhineland, Wis., this 16th day of June, 1975.
Signature Phillip T. Hansen Title Registered Land Surveyor Registration No. S-498
(County Surveyor, Registered Land Surveyor, or other duly authorized official)

Office of Register of Deeds, County of Oneida.
Instrument was filed in this office for record on the 1st day of October, 1975 at 3:00 o'clock P. M. I hereby certify that the within

Joni Savage Kuehn
(Register of Deeds)

By: _____ Deputy

01010601199