



CERTIFIED LAND CORNER RESTORATION

Index No. **G-12**

State of Wisconsin

County of Oneida } ss.

I Philip T. Hansen, do hereby certify that on the 30th day of January, 1975, I found evidence of the EC-1/16 corner of Section 9 Township 36, North, Range 11 E, Fourth Principal Meridian, as described hereon; and that from this evidence I established a new monument and accessories as described hereon to perpetuate the original location of this corner.

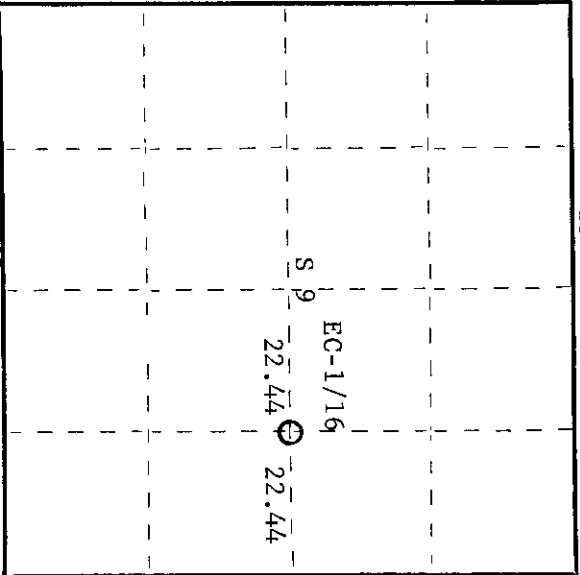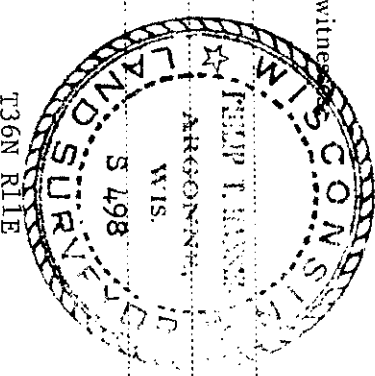

○ = Corner monument restored.

History of original corner establishment:

Corner set by D.H. Vaughan, County Surveyor, in 1904. This corner recovered by H.C. Lawrence Registered Land Surveyor, during his retracement survey in 1952; however, he found it to be in error, as his N-S-1/4 line crossed the E-W-1/4 line, 124 links west of Vaughan's survey and 41 links south of Vaughan's C-1/4. He set his EC-1/16 corner 62 links west of its recovered position, equidistant between the C-1/4 corner and the E-1/4 corner at 22.44 chains. Set NBT's - cedar 18", N76E, 42 links; cedar 7", S67°E, 24-1/2 links. Defaced what remained of Vaughan's BT's.

Description of corner evidence found:  
Recovered H.C. Lawrence's 4" cedar post, squared and scribed EC-1/16 S9 in fair condition.

Recovered - Cedar 18" N76°E 42 links dead but sound scribed EC-1/16 NBT  
Cedar 7" S67°E 24-1/2 links green scribed S9 NBT

Description of monument and accessories I established to perpetuate the original location of this corner.

Replaced old post with 1-1/4"OD x 5' galvanized iron pipe w/brass cap  
stamped - S498 T36N R11E

NBT - Cedar 10" S70°W 25 links scribed 1/16 BT EC-1/16 S9 CPT-1975

Dated at Rhineland, Wis., this 16th day of June, 1975.

Signature Philip T. Hansen Title Registered Land Surveyor Registration No. S-498  
(County Surveyor, Registered Land Surveyor, or other duly authorized official)

Office of Register of Deeds, County of Oneida I hereby certify that the within instrument was filed in this office for record on the 1st day of October, 1975 at 3:00 o'clock P.M.

Doris Savage Kuehn  
(Register of Deeds)

By: \_\_\_\_\_ Deputy

3611092010