

CERTIFIED LAND CORNER RESTORATION

Index No. **G-10**

State of Wisconsin } ss.

County of Oneida

Phillip T. Hansen, do hereby

certify that on the 8th day

of May 1975, I found

evidence of the WC-1/16



corner of Section 9

Township 36 North, Range

11 East, Fourth Principal Meridian,

as described hereon; and that from this evidence I established a new monument and accessories as described hereon to perpetuate the original location of this corner.

Resident witnesses:

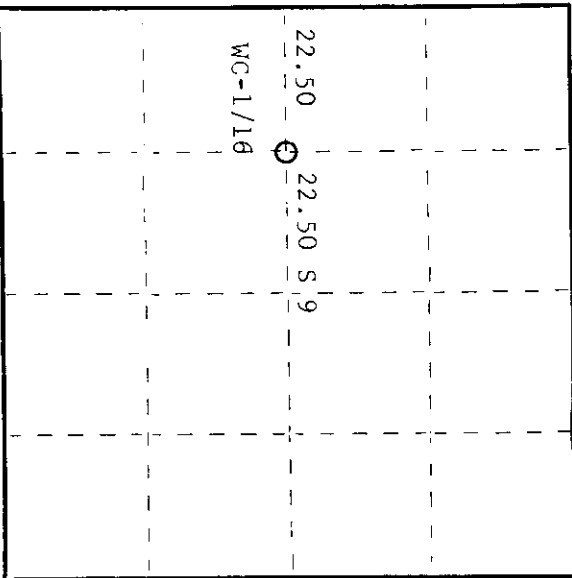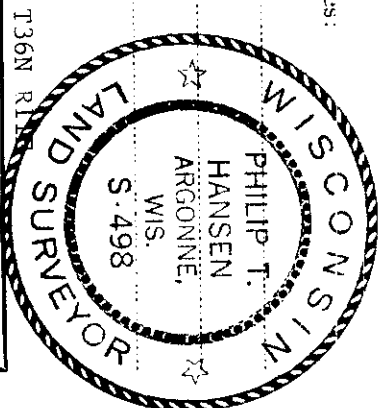

○ = Corner monument restored.

History of original corner establishment:

Original corner established by D.H. Vaughan, County Surveyor, in 1912. H.C. Lawrence, Registered Land Surveyor, retraced his survey in 1947 and discovered an error in Vaughan's work. Lawrence ran the E-W - N-S quarter lines to establish the C₂ corner. He set the WC-1/16 corner 20 links south of the true corner, which lies in the E-W road. Established BT - cedar 12" S55°E 47 links.

Description of corner evidence found:

Recovered a 4" cedar post, squared and scribed WC-1/16 S9, WC-1/16 S9, in fair condition. Also recovered a 1 1/2" iron pipe setting beside the wooden stake.

Recovered OBT - cedar 12" S55°E 47 links, scribed WC-1/16 BT.

Description of monument and accessories I established to perpetuate the original location of this corner.

Replaced 4" cedar post with 1 1/2" O.D. iron pipe with 2" brass cap stamped -

S498

NBT - black spruce 7" west 48.4 links, scribed 1/16 BT.

T36N R11E

WC-1/16 S 9

W.C. N 20 links

CPI-1975

Dated at Rhineland, Wis., this 7th day of July, 1975.

Signature *Phillip T. Hansen* Title Registered Land Surveyor Registration No. S-498
(County Surveyor, Registered Land Surveyor, or other duly authorized official)

Office of Register of Deeds, County of Oneida
Instrument was filed in this office for record on the 1st day of October 1975
at 3:00 o'clock P.M.

Doris Verage Kuehn
(Register of Deeds)

By Deputy

0302 601198