

CERTIFIED LAND CORNER RESTORATION

Index No. J-17

State of Wisconsin

County of Oneida } ss.

I Phillip T. Hansen, do hereby certify that on the 24th day of January, 1975, I found evidence of the Section

corner of Sections 10, 11, 14, and 15

Township 36 North, Range


11 East, Fourth Principal Meridian,

as described hereon; and that from this evidence I established a new monument and accessories as described hereon to perpetuate the original location of this corner.

Resident witnesses:

M. Strain

G. Barker

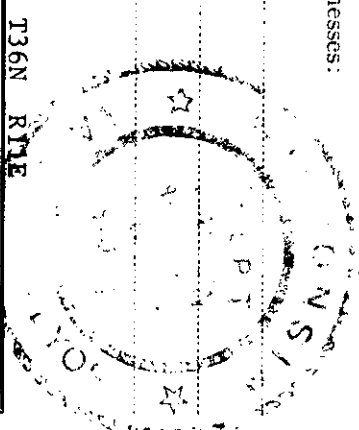

T36N R11E

S 10

SC

○ = Corner monument restored.

History of original corner establishment:

Original corner established by Wm. E. Dougherty, Deputy Surveyor, in 1859, from which White Pine 12" bears S59°E 13 links and Spruce 7" bears N76°W 18 links. Corner recovered by H.C. Lawrence, Registered Land Surveyor, in 1952. Recovered White Pine stump 18" S53°E 14 links. Set new tamarack post and marked NBT - White Birch 20" S47°E 21 links.

Description of corner evidence found:

Recovered 2 - 4" cedar posts, squared and scribed S10, S11, S14, S15 in very poor condition. Recovered birch stub, scribed S14 BT. Recovered OBT - Pine, now a rotted stump (original).

Description of monument and accessories I established to perpetuate the original location of this corner.

Replaced rotted posts with 2-1/2" Berntsen A-1 Federal Monument, stamped: Monument projects 16".

Set witness posts -

- 1" iron pipe N31°E 8 links T36N R11E
- 1" iron pipe S81°E 8 links S10 + S11
- 1" iron pipe S33°W 7.8 links S15 + S14
- S498 - 1975

Dated at Rhineland, Wis., this 28th day of January, 1980

Signature: *Phillip T. Hansen* Title: Registered Land Surveyor Registration No. S-498 (County Surveyor, Registered Land Surveyor, or other duly authorized official)

Office of Registrar of Deeds, County of Oneida. I hereby certify that the within instrument was filed in this office for record on the 11th day of February, 1980 at 2:15 o'clock P.M.

Signature: *Dorci Vergara Fuchs* (Registrar Deeds)

By: Deputy