

CERTIFIED LAND CORNER RESTORATION

Index No. **5-14**


State of Wisconsin }  
 County of Oneida } ss.

I Phillip T. Hansen, do hereby certify that on the 17th day of January, 1975, I found evidence of the W-1/16 corner of Sections 10

Township 36-15, North, Range 11 East, Fourth Principal Meridian,

as described hereon; and that from this evidence I established a new monument and accessories as described hereon to perpetuate the original location of this corner.

Resident witnesses:

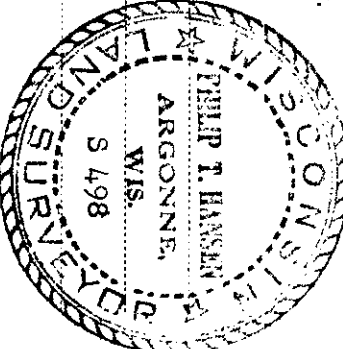

History of original corner establishment:

Corner established by H.C. Lawrence, Registered Land Surveyor, during his retracement survey in 1952. He ran N89°00'E from the corner Sec. 9-10-15-16, 86.65 chains to a point 94 lks. North of original corner Sec. 10-11-14-15. Corrected line and bearing, new corrected bearing was N89°38'E. He set a 5" cedar post on line, equidistant between the SW section corner and the 1/4 Corner. Established new BT's - Black ash 10" S10°W 19 lks.; Black ash 9" N22°W 40 lks.

Description of corner evidence found:


Unable to recover Lawrence's 5" cedar post.

Recovered BT's. Black ash 10" S10°W 19 lks. in good condition scribed S15 1/16 BT  
 Black ash 9" N22°W 40 lks. dead and broken off. Scribe marks intact.  
 S10 BT


Description of monument and accessories I established to perpetuate the original location of this corner.

New 1-1/4" O.D. x 5' iron pipe set from intersection and bearings of old BT's stamped -

New BT. Black ash 8" N44°W 47.6 lks. Scribed 1/16 BT T36N, R11E S498

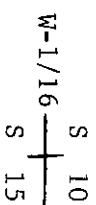

CPI-1975

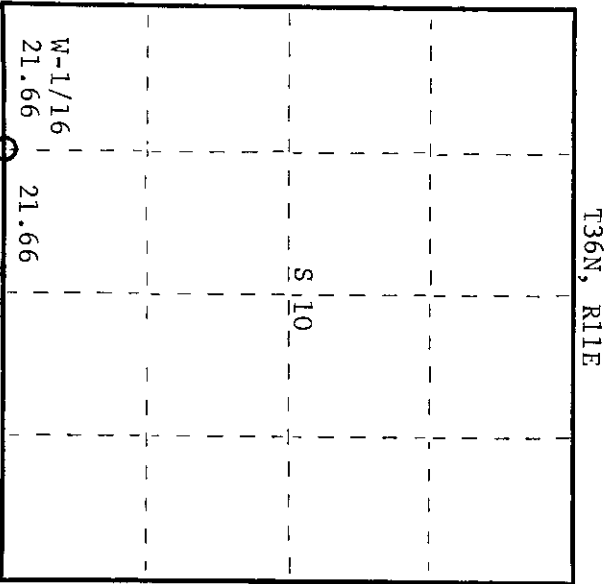

○ = Corner monument restored.

Dated at Rhinelander, Wis., this 10th day of June, 1975.

Signature: *Phillip T. Hansen* Title: Registered Land Surveyor Registration No. S-498  
 (County Surveyor, Registered Land Surveyor, or other duly authorized official)

Office of Register of Deeds, County of Oneida. On this 1st day of October, 1975, I hereby certify that the within instrument was filed in this office for record on the 300th day of the year at 3:00 o'clock P.M.

*Doris Verage Kuehn*  
 (Register of Deeds)

By: \_\_\_\_\_ Deputy

02000 011192