

CERTIFIED LAND CORNER RESTORATION

Index No. H-15

State of Wisconsin } ss.  
County of Oneida

History of original corner establishment:  
Corner established by H.C. Lawrence, Registered Land Surveyor, retracement survey of 1952. Set 6" cedar post, squared and scribed S10 SC-1/16 equidistant between established C-1/4 corner and S-1/4.


Established BT's - White birch 8" S80°E 47½ links  
Maple 14" S80°E 74½ links

I Philip T. Hansen, do hereby certify that on the 21st day of January, 19 75, I found evidence of the SC-1/16 corner of Section 10 Township 36, North, Range 11 East, Fourth Principal Meridian, as described hereon; and that from this evidence I established a new monument and accessories as described hereon to perpetuate the original location of this corner.

Description of corner evidence found:  
Recovered 6" cedar post, squared and scribed S10 SC-1/16 in poor condition, post was lying on ground.

Recovered BT's - White birch 8" S80°E 47½ links scribing grown over but o.k.  
Maple 14" S80°E 74½ links scribing grown over but o.k.

Resident witnesses:

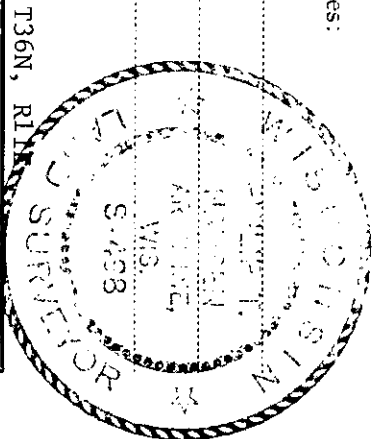


Description of monument and accessories I established to perpetuate the original location of this corner.  
Set 1-1/4" O.D. x 5' galvanized iron pipe with 2" brass cap stamped -

No NBT's set.

S498  
T36N, R11E

SC-1/16 S+10

CPI-1975

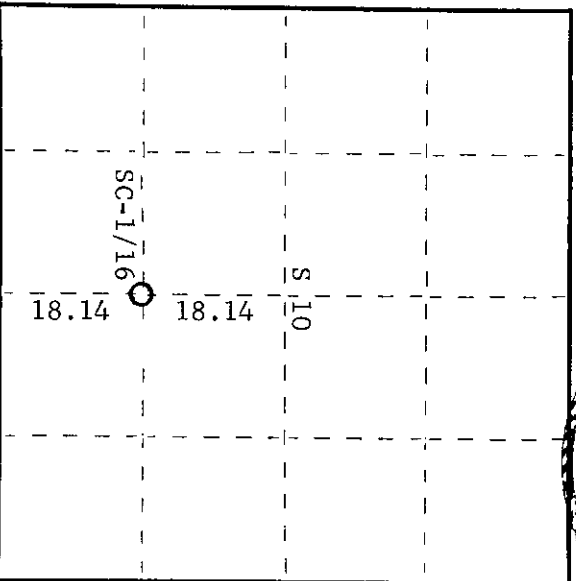

○ = Corner monument restored.

Dated at Rhinelander, Wis., this 16th day of June, 19 75.

Signature Philip T. Hansen Title Registered Land Surveyor Registration No. S-498  
(County Surveyor, Registered Land Surveyor, or other duly authorized official)

Office of Register of Deeds, County of Oneida 1st day of October, 19 75  
I hereby certify that the within instrument was filed in this office for record on the 30<sup>th</sup> day of October, 19 75 at 3:00 o'clock P. M.

Tonia Verage Juch  
(Register of Deeds)

By Tonia Verage Juch Deputy

3611101020