



CERTIFIED LAND CORNER RESTORATION

Index No. H-14

State of Wisconsin }
 County of Oneida } ss.

I, Philip T. Hansen, do hereby certify that on the 23rd day of January, 1975, I found evidence of the SW-1/16 corner of Section 10 Township 36 North, Range 11 E, Fourth Principal Meridian, as described hereon; and that from this evidence I established a new monument and accessories as described hereon to perpetuate the original location of this corner.

Resident witnesses:

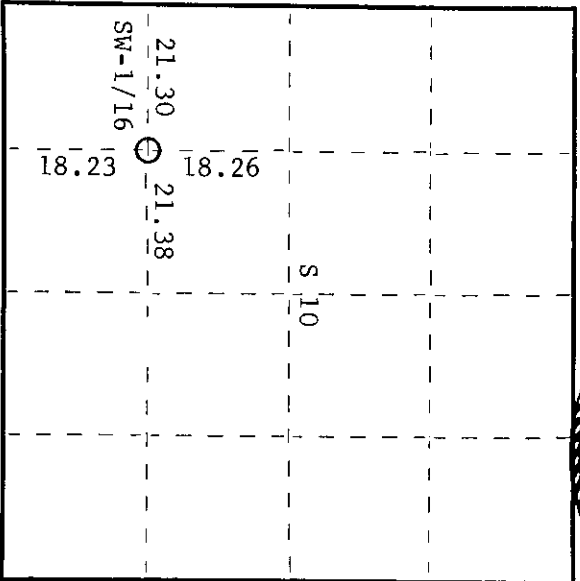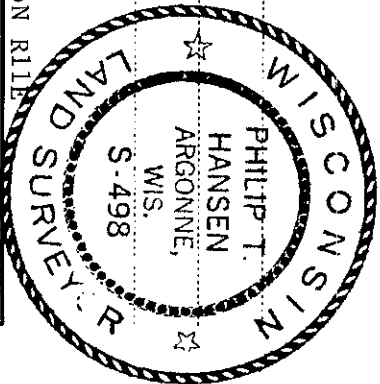

○ = Corner monument restored.

CERTIFIED LAND CORNER RESTORATION

History of original corner establishment:

Corner established by H.C. Lawrence, Registered Land Surveyor, in 1953. From S-1/16 corner between Sections 9 and 10, he ran S89°45'E at 21.18 chains intersected N-S-1/4 line of SW-1/4 at a point 18.50 south, at 42.68 chains intersected N-S-1/4 line at point 49 links south of SC-1/16 post. Corrected bearing N89°35'E. Set 5" cedar post at 18.26 south of WC-1/16 and 21.30 east of S-1/16 corner between S9 and S10.

Nothing suitable for BT's.

Description of corner evidence found:

Recovered 5" cedar post, squared and scribed S10 SW-1/16 SW-1/16 S10 in fair condition.
 No BT's recovered.

Description of monument and accessories I established to perpetuate the original location of this corner.

Replaced wooden post with 1-1/4"OD x 5' iron pipe with 2" brass cap stamped -

NBT's - Sugar maple 10"	N69°0'W	28.2 links scribed 1/16 BT	S498
Sugar maple 8"	S12°0'W	27.4 links scribed 1/16 BT	T36N R11E
			SW-1/16 - S10
			CPI-1975

Dated at Rhineland, Wis., this 22 day of May, 1975.

Signature: Philip T. Hansen Title: Registered Land Surveyor Registration No. S-498
 (County Surveyor, Registered Land Surveyor, or other duly authorized official)

Office of Register of Deeds, County of Oneida. I hereby certify that the within instrument was filed in this office for record on the 1st day of October, 1975 at 3:00 o'clock P.M.

Doris Verage Kuehn
 (Register of Deeds)

By: _____ Deputy

0011101020