


CERTIFIED LAND CORNER RESTORATION

Index No. **G-16**


State of Wisconsin

County of Oneida } ss.

I Philip T. Hansen, do hereby certify that on the 16th day of January, 19 75, I found evidence of the EC-1/16 corner of Section 10 Township 36, North, Range 11 East, Fourth Principal Meridian, as described hereon; and that from this evidence I established a new monument and accessories as described hereon to perpetuate the original location of this corner.

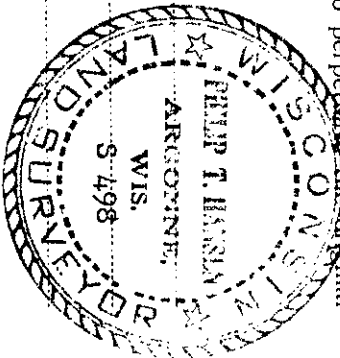

Resident witnesses:

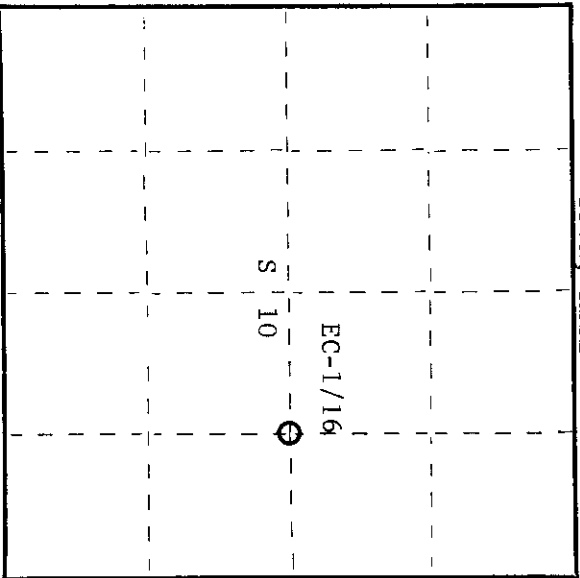

○ = Corner monument restored.

History of original corner establishment:

Corner established by H.C. Lawrence, Registered Land Surveyor, on his retracement survey in 1952. No record of corner having been established at a prior date. His notes state that he ran the N-S 1/4 line from the 1/4 Sections 3 and 10, S4030'E 72.34 chains to a point 1.34 chains West of 1/4 between Sec. 10/15. Corrected line and bearing - Correction bearing 1032' - Corrected bearing S6002'E.

Ran East-West 1/4 line due East and intersected corrected 1/4 line at 41.92 chains and E-1/4 Corner at 86.58 chains - 110.09 chains South of Town line. Set 4" cedar post on line equidistant between C-1/4 Corner and East 1/4 Corner. Nothing suitable for BT.

Description of corner evidence found:

Recovered Lawrence's 4" cedar post, squared and scribed EC-1/16 S10 in fair condition. Stake leaning over but point in hole.

No BT's recovered.

Description of monument and accessories I established to perpetuate the original location of this corner.

Set 1-1/4" O.D. x 5' iron pipe with 2" brass cap stamped -

New BT's. Black spruce 8" S180W 80-3/4 lks. Scribed 1/16 BT T36N, R11E
White Birch 10" N190E 79-3/4 lks. Scribed 1/16 BT S 10

EC-1/16

CPT-1975

Dated at Rhineland, Wis., this 16th day of June, 19 75.

Signature Philip T. Hansen Title Registered Land Surveyor Registration No. S-498
(County Surveyor, Registered Land Surveyor, or other duly authorized official)

Office of Register of Deeds, County of Oneida I hereby certify that the within instrument was filed in this office for record on the 1st day of October, 19 75 at 3:00 o'clock P.M.

Terrie Leverage Fuchs
(Register of Deeds)

By _____ Deputy

36 11 10 20 10