CERTIFIED LAND CORNER RESTORATION

Index No. G-14

State of Wisconsin
County of Oneida } ss.

I Philip T. Hansen, do hereby certify that on the 17th day of January, 19 75, I found evidence of the WC-1/16 corner of Section 10 Township 36, North, Range 11 East, Fourth Principal Meridian, as described hereon; and that from this evidence I established a new monument and accessories as described hereon to perpetuate the original location of this corner.

Resident witnesses:

WISCONSIN PHILIP T. HANSEN Rhinelander, Wis. S-498 LAND SURVEYOR

T36N, R11E

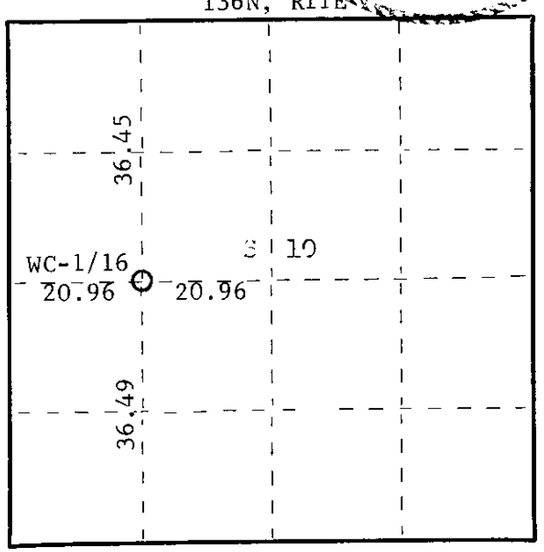

○ = Corner monument restored.

History of original corner establishment:
Corner established by H.C. Lawrence, Registered Land Surveyor, during his retracement survey in 1952. Set corner equidistant between W-1/4 corner and center 1/4 on corrected random line. Set 4" cedar post, squared and scribed S10 WC-1/16.

Established BT's - Elm 5" N80E 38 links
Elm 12" N23W 25 links

Description of corner evidence found:
Recovered 4" cedar post, squared and scribed S10 WC-1/16 in fair condition.

Recovered BT's - Elm 5" N80E 38 links
Elm 12" N23W 25 links scribing grown over

Description of monument and accessories I established to perpetuate the original location of this corner.
Set 1-1/4" O.D. x 5' galvanized pipe with brass cap stamped -

S498
T36N, R11E
WC-1/16 S 10

CPI-1975

Dated at Rhinelander, Wis., this 13th day of June, 19 75

Signature Philip T. Hansen Title Registered Land Surveyor Registration No. S-498
(County Surveyor, Registered Land Surveyor, or other duly authorized official)

Office of Register of Deeds, County of Oneida, I hereby certify that the within instrument was filed in this office for record on the 1st day of October, 19 75 at 3:00 o'clock P. M.

Doris Verage Kuehn
(Register of Deeds)

By ..... Deputy

FORM 985 H. C. MILLER CO., MILWAUKEE

361102030