



CERTIFIED LAND CORNER RESTORATION

Index No. **F-16**

State of Wisconsin }  
County of Oneida } ss.

I Phillip T. Hansen, do hereby  
certify that on the 16th day  
of January, 1975, I found  
evidence of the NE-1/16  
corner of Section 10  
Township 36, North, Range  
11 East, Fourth Principal Meridian,  
as described hereon; and that from this evidence  
I established a new monument and accessories  
as described hereon to perpetuate the original  
location of this corner.

Resident witnesses.

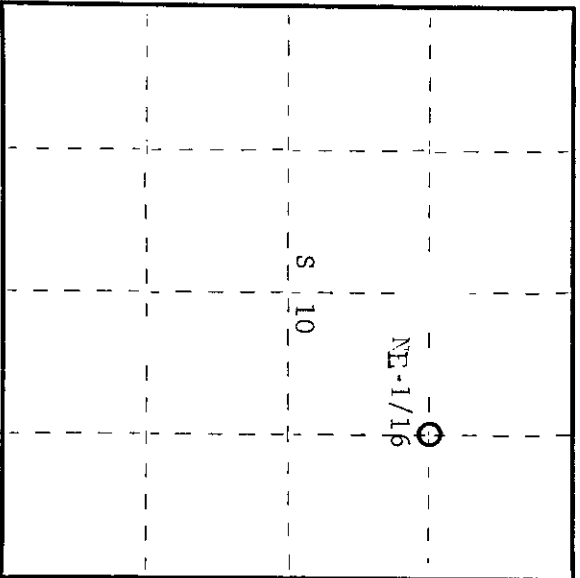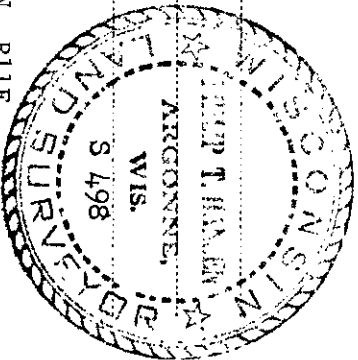

○ = Corner monument restored.

History of original corner establishment:  
Corner established by H.C. Lawrence, Registered Land Surveyor, during his retracement  
survey in 1952.

Set 5" cedar post in old logging road and establish new BT's.

Black ash 6" S25E 8-1/2 lks.  
Black ash 12" N10W 49-1/2 lks.

Description of corner evidence found:  
No trace of 5" cedar post found.

Recovered Black ash 10", dead but scribing visible NE-1/16 BT.  
Recovered Black ash 6", live and sound. Scribing grown over.

Description of monument and accessories I established to perpetuate the original location of this corner.

Set new 1-1/4" O.D. iron pipe with brass from distances and bearings from  
old BT's stamped -

New BT. Black ash 9" 64 lks. Scribbed 1/16 BT (no bearing) S498  
T36N, R11E  
NC-1/16 +  
S 10

GPI-1975

Dated at Rhineland, Wis., this 16th day of June, 1975.

Signature: Phillip T. Hansen Title Registered Land Surveyor Registration No. S-498  
(County Surveyor, Registered Land Surveyor, or other duly authorized official)

Office of Register of Deeds, County of Oneida I hereby certify that the within  
instrument was filed in this office for record on the 1st day of October, 1975  
at 3:00 o'clock P. M.

Torrie Savage Tuelke  
(Register of Deeds)

By: \_\_\_\_\_ Deputy

0102 011192