



CERTIFIED LAND CORNER RESTORATION

Index No. J-25

State of Wisconsin }
 County of Graida } ss.

I, Phillip T. Hansen, do hereby certify that on the 5th day of December, 1974, I found evidence of the Southwest corner of Section 36, Township 36, North, Range 11, Fourth Principal Meridian, as described hereon; and that from this evidence I established a new monument and accessories as described hereon to perpetuate the original location of this corner.

Resident witnesses:

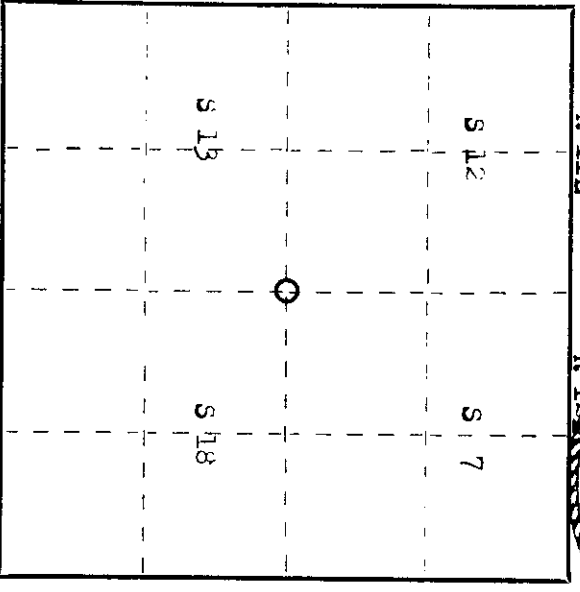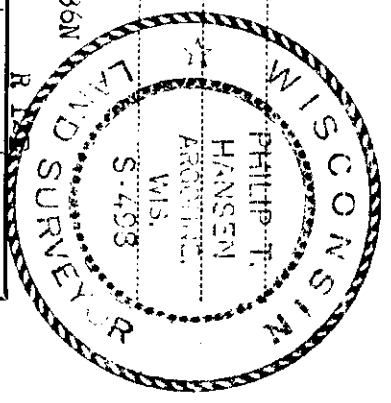

History of original corner establishment:

Original corner established in 1859 by William E. Dougherty, Gov. Deputy Surveyor
 Y. Pine 20" N20E 55 lks
 Cedar 12" N30W 7 lks
 Tamarack 15" S 5W 50 lks
 Cedar 10" S65E 42 lks

Description of corner evidence found: Recovered 4" x 4" Cedar post, square, very old. Recovered old yellow pin stump, scribe obliterated (orig. BT South Recovered H.J. Lawrence 5" scribed post established in 1956, fair condition. Recovered 4" post, scribed BT origin unknown.

Description of monument and accessories I established to perpetuate the original location of this corner. Set 2 1/2" x 5" Galvanized iron pipe with brass cap stamped as follows: Set the following new BTs:

- Cedar 11" N73E 44 lks S-498
- Cedar 11" S16E 33 lks T36N
- Cedar post S64E 41 1/2" Scribed BT R11E S12 S7
- CPI 1974 S13 S13 R12E

Dated at Rhineland, Wis., this 17th day of December, 1974.
 Signature Phillip T. Hansen Title Registered Land Surveyor Registration No. S-498
 (County Surveyor, Registered Land Surveyor, or other duly authorized official)
 Office of Registrar of Deeds, County of Graida On 5th day of October, 1975.
 Instrument was filed in this office for record on the 300 o'clock at MI.

Tomie Vergara Weeks
 (Registrar of Deeds)

By Tomie Vergara Weeks Deputy

○ = Corner monument restored.

0000411198