



CERTIFIED LAND CORNER RESTORATION

Index No. J-24

State of Wisconsin }  
 County of Oneida } ss.

I Philip T. Hansen do hereby  
 certify that on the 30th day  
 of December, 1974, I found  
 evidence of the E-1/16  
 corner of Sections 12 and 13  
Township 36, North, Range  
11 East, Fourth Principal Meridian,  
 as described hereon; and that from this evidence  
 I established a new monument and accessories  
 as described hereon to perpetuate the original  
 location of this corner.

Resident witnesses:

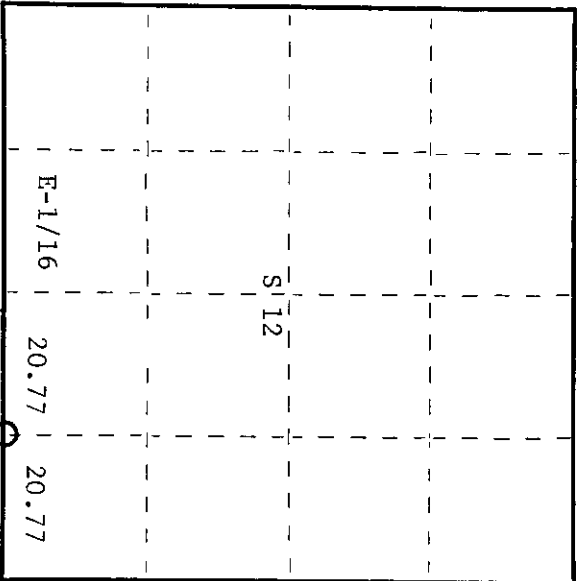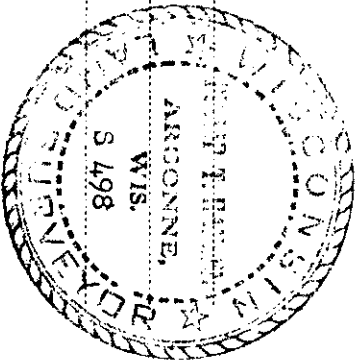

History of original corner establishment:

Corner established by H.C. Lawrence, Reg. Land Surveyor on his retracement survey of 1948. He states that from B.F. Dorr's 1/4 post and evidence of his two pine BT's, he ran S87°E 41.54 chains, at which the Section Corner bears N30E a distance of 3.30 chains. Correction was 40'35" or a true bearing of N88°25'E. He set the E-1/16 Corner at 20.77 chains equidistant from the 1/4 corner and offset 165 lks. North of random line. Set a 5" cedar post with BT's. Cedar 8", S60E, 59½ lks; maple 9", N66W, 5 lks.

Description of corner evidence found:

Recovered 5" cedar post, squared and scribed S12 E-1/16 S13 in fair condition.  
 Recovered BT's      Red maple 9"      N76W      5 lks.  
                          Cedar 8"      S60E      59½ lks.

Description of monument and accessories I established to perpetuate the original location of this corner.

Set a 1" x 5' galvanized iron pipe with brass cap stamped as follows -  
 New BT      Red maple 6"      S74°E      90 lks.      scribed 1/16 BT      T36N, R11E      S498

S 12  
 E-1/16 +  
 S 13  
 CPL-1974

Dated at Rhineland, Wis, this 16th day of June, 1975.

Signature Philip T. Hansen Title Registered Land Surveyor Registration No. S-498  
 (County Surveyor, Registered Land Surveyor, or other duly authorized official)

Office of Register of Deeds, County of Oneida. I hereby certify that the within instrument was filed in this office for record on the 1st day of October, 1975 at 3:00 o'clock P. M.

Doris Verage Kuelin  
 (Register of Deeds)

By: \_\_\_\_\_ Deputy