

CERTIFIED LAND CORNER RESTORATION



Index No. **J-23**

State of Wisconsin

County of Oneida } ss.

I Philip T. Hansen, do hereby certify that on the 4th day of December, 1974, I found evidence of the 1/4 corner of 12-13 Township 36 North, Range 11 East, Fourth Principal Meridian, as described hereon; and that from this evidence I established a new monument and accessories as described hereon to perpetuate the original location of this corner.

Resident witnesses:

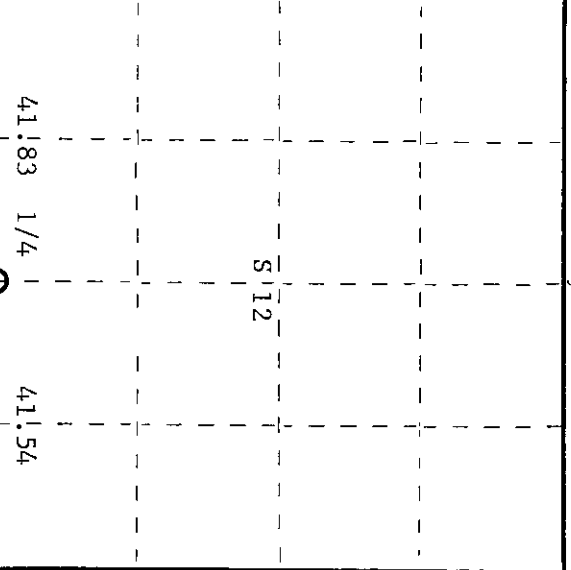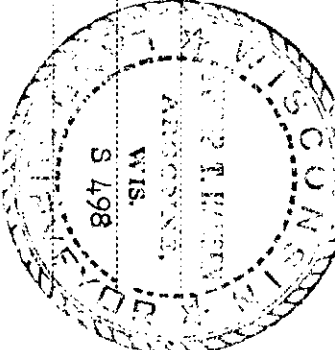

History of original corner establishment:

Original corner established by Wm. E. Dougherty, Gov't Deputy Surveyor in 1859.

Birch 7"	S37E	8 lks.
Fir 6"	N42W	8 lks.

B.F. Dorr, County Surveyor reset corner in 1897.

Pine 12"	N59E	19 1/2 lks.
Pine 14"	N63W	41 lks.

H.C. Lawrence, Reg. Surveyor's retracement survey of 1948 states that he recovered B.F. Dorr's 1/4 corner set in 1897 and evidence of his BT's but they were rotted stumps then. He set a new 6" cedar post along side of the old post and made new bearing trees.

Hemlock 14"	N18W	49 lks.
Hemlock 10"	S14E	39 1/2 lks.

Description of corner evidence found: Recovered H.C. Lawrence's 6" cedar post, squared and scribed 1/4 S12, 1/4 S13 in good condition. Dorr's old post, poor condition, was lying beside it.

Recovered BT's	Pine stump 12"	N59E	19 1/2 lks.
	Hemlock 15"	N18W	48 1/2 lks. (now dead)
	Pine stump 14"	S8E	40 1/2 lks.

Description of monument and accessories I established to perpetuate the original location of this corner.
Set new 2-1/2" x 5' galvanized iron pipe with brass cap stamped as follows -

New BT	Sugar maple 6"	S70E	47 1/2 lks.	scribed 1/4 BT	T36N, R11E	S498
--------	----------------	------	-------------	----------------	------------	------

S 12
1/4-
S 13

CPI-1974

Dated at Rhineland, Wis. this 16th day of June, 19 75.

Signature: [Signature] Title: Registered Land Surveyor Registration No. S-498
(County Surveyor, Registered Land Surveyor, or other duly authorized official)

Office of Register of Deeds, County of Oneida. I hereby certify that the within instrument was filed in this office for record on the 1st day of October, 1975 at 3:00 o'clock P.M.

[Signature]
(Register of Deeds)

By: _____ Deputy

980000020