

CERTIFIED LAND CORNER RESTORATION

Index No. **G-24**

State of Wisconsin

County of Oneida } ss.

Phillip T. Hansen, do hereby


certify that on the 30th day of December 1974, I found

evidence of the EC-1/16 corner of the Section 12


Township 36 North, Range 11 East, Fourth Principal Meridian,

as described hereon; and that from this evidence I established a new monument and accessories as described hereon to perpetuate the original location of this corner.

Resident witnesses:

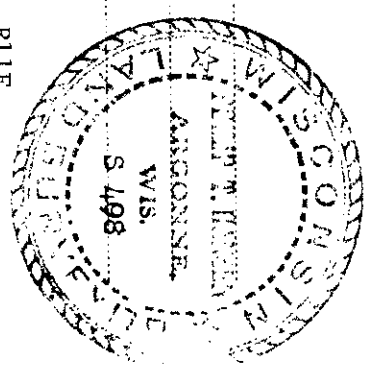

T36N, R11E

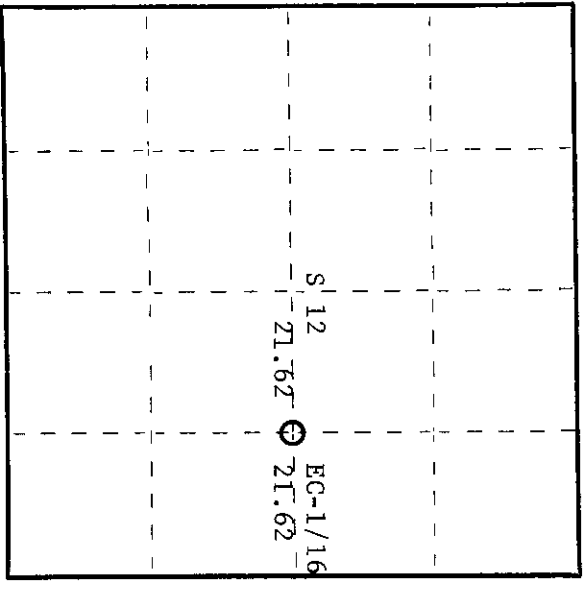

○ = Corner monument restored.

History of original corner establishment:

No record of EC-1/16 Corner having been set.

Corner established by H.C. Lawrence, Reg. Surveyor in 1956. Starting from the C-1/4 Corner ran N87°20'E on random line. 43.24 chains to the East 1/4 post intersecting the East line 37 lks. North of 1/4 corner at right angles. Corrected line and set EC-1/16 Corner at 21.62 chains equidistant marked bearing trees.

Cedar 9" N85E 30 1/2 lks.  
Black ash 8" N30E 27 lks.

Description of corner evidence found:

Recovered H.C. Lawrence's 4" cedar post, squared and scribed EC-1/16, S12 in good condition.

Recovered bearing trees Black ash 8" scribed S12 27 lks.  
Cedar 9" scribed EC-1/16 BT 30 1/2 lks.

Description of monument and accessories I established to perpetuate the original location of this corner.

Set new 1" x 5' galvanized iron pipe with 2" brass cap stamped as follows -

New BT's White birch 6" S52°W 23 lks. scribed 1/16 BT T36N, R11E S498

EC-1/16 S12

Dated at Rhinelander Wis., this 16th day of June 1975

Signature: *Phillip T. Hansen* Title: Registered Land Surveyor Registration No. S-498  
(County Surveyor, Registered Land Surveyor, or other duly authorized official)

Office of Register of Deeds, County of Oneida On sida 1st day of October 1975  
at 3:00 o'clock P.M. hereby certify that the within instrument was filed in this office for record on the

Signature: *Donna Verage Kuehn*  
(Register of Deeds)

By: Deputy

36112 2010