


CERTIFIED LAND CORNER RESTORATION

Index No. F-23

State of Wisconsin } ss.  
 County of Oneida

I Philip T. Hansen, do hereby certify that on the 16th day of December 1974, I found evidence of the NC 1/16 corner of Sec. 12 Township 36 N., Range 11 East, Fourth Principal Meridian, as described hereon; and that from this evidence I established a new monument and accessories as described hereon to perpetuate the original location of this corner.

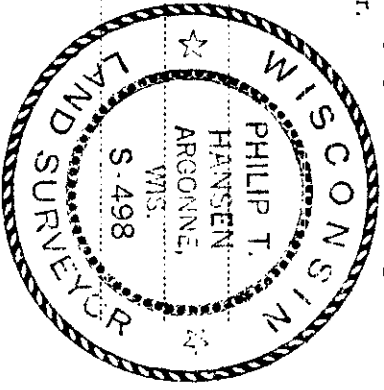

Resident witnesses:

History of original corner establishment:  
 Retracement survey of 1956 by H.C. Lawrence, notes state that he ran S4°00' E mag. from the 1/4 corner between Sections 1 and 12, a distance of 37.81 chains to the East-West 1/4 line to a point 29 links east of Dorr's C-1/4 corner. He set a 5" cedar post at the NC-1/16 corner, 14-1/2 links west of random line and 18.90-1/2 chains equidistant between the corners.

B. spruce 8" S11W  
 Aspen 9" N70E

Description of corner evidence found:  
 Recovered the 5" cedar post, squared and scribed NC-1/16 S12 NC-1/16 in good condition.  
 No trace of bearing trees.

Description of monument and accessories I established to perpetuate the original location of this corner.  
 Replaces 5" cedar post with 1" x 5' galvanized iron pipe with 2" brass cap stamped as follows:

N.B.T.'s	Black spruce 8"	N66W	77 links	scribed 1/16 B.T.	S498
	Black spruce 5"	N45E	30 links	scribed 1/16 B.T.	T36N R11E

NC-1/16 +  
 S12


Dated at Rhinelander, Wis., this 16th day of December, 1974. CPI-1974

Signature Philip T. Hansen Title Registered Land Surveyor Registration No. S-498  
 County Surveyor, Registered Land Surveyor, or other duly authorized official

Office of Register of Deeds, County of Oneida  
 Instrument was filed in this office for record on the 1st day of October, 1975 at 3:00 o'clock P.M.

Doris Verage Tuelke  
 (Register Deeds)

By \_\_\_\_\_ Deputy

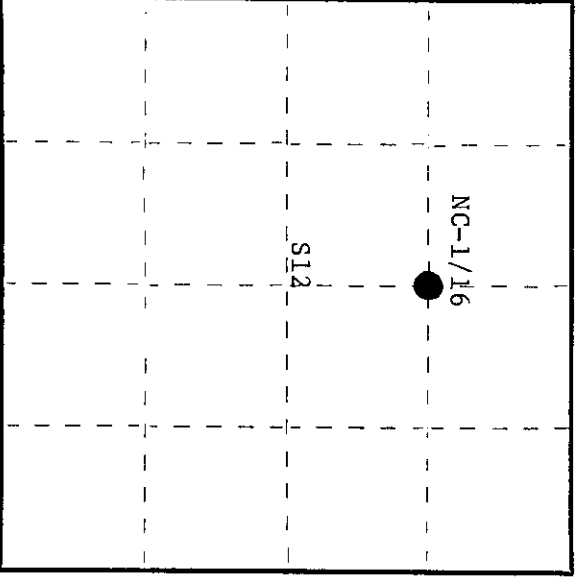

○ = Corner monument restored.

361123020