

State of Wisconsin



County of Oneida } ss.

I Philip T. Hansen, do hereby certify that on the 7th day of October, 1975, I found evidence of the Section corner of Sections 13, 18, 19, and 24 Township 36 North, Range 11 and 12 East, Fourth Principal Meridian, as described hereon; and that from this evidence I established a new monument and accessories as described hereon to perpetuate the original location of this corner.

Resident witnesses:

Glen Barker

Jim Claflin

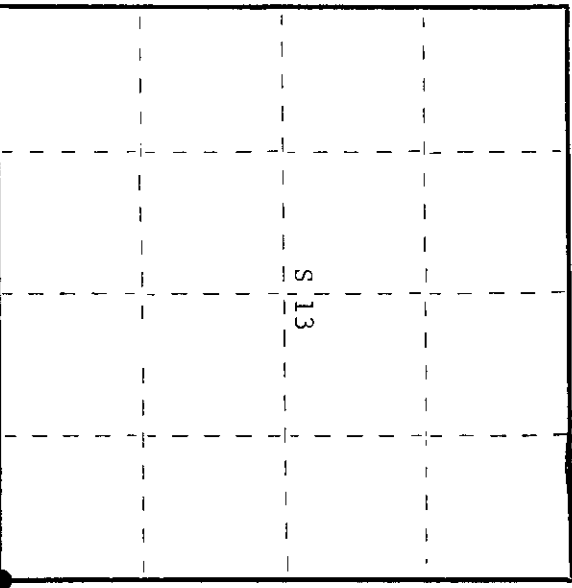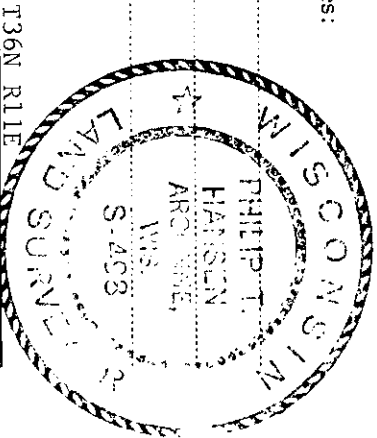

○ = Corner monument restored.

History of original corner establishment:

Original corner established by Alfred Millard, Government Deputy Surveyor, in 1858 from which white pine 10" bears N25°E, 18 links; white pine 12" bears N65°W, 49 links; and white pine 12" bears S40°W, 30 links. Corner restored by H.C. Lawrence, Registered Land Surveyor, in 1950. Recovered OBT's: White pine stump S40°W 30 links, White pine stump N25°E 18 links, with scribe marks. Set new post from these BT's. A balsam 18" had been marked for BT but no notes were available for it. Rescribed balsam S16°E, 20 links.

Description of corner evidence found:

Recovered 5" tamarack post, squared and scribed S13 R11E, S24 T36N, S19, S18 R12E, in fair condition. Recovered OBT's: Original white pine 12" S40°W 31 links - now a decayed stump. Balsam 18" S16°E 20 links - scribing rotted out.

Description of monument and accessories I established to perpetuate the original location of this corner.

Replaced tamarack post with 2-1/2" Berntsen A-1 Federal Monument. Aluminum with magnet installed in cap and base, projecting 6" above ground.

Cap stamped -

NBT's: B. spruce 6" S40°W 29.6 links - scribed SC BT. S498 T36N

B. spruce 6" N45°W 26.5 links - scribed SC BT.

Post and BT's painted blue.

R 11 13 18 12  
E 24 19 E

1975

Dated at Rhineland, Wis. this 10th day of October, 1975.

Signature: *Philip T. Hansen* Title: Registered Land Surveyor Registration No. S-498  
(County Surveyor, Registered Land Surveyor, or other duly authorized official)

Office of Register of Deeds, County of Oneida  
at 10:00 o'clock A.M. I hereby certify that the within instrument was filed in this office for record on the 17th day of November, 1975.

*Donna George Kuehler*  
(Register of Deeds)

By: Deputy

3611130000