

CERTIFIED LAND CORNER RESTORATION



Index No. **K-25**

State of Wisconsin }
 County of Oneida } ss.

I Phillip T. Hansen, do hereby certify that on the 18th day of March, 1976, I found evidence of the N 1/16 corner of Sec. 13 and 18 Township 36, North, Range 11 East, Fourth Principal Meridian, as described hereon; and that from this evidence I established a new monument and accessories as described hereon to perpetuate the original location of this corner.

Resident witnesses:

Glen Barker
Jim Clafin
Herb Wagoner

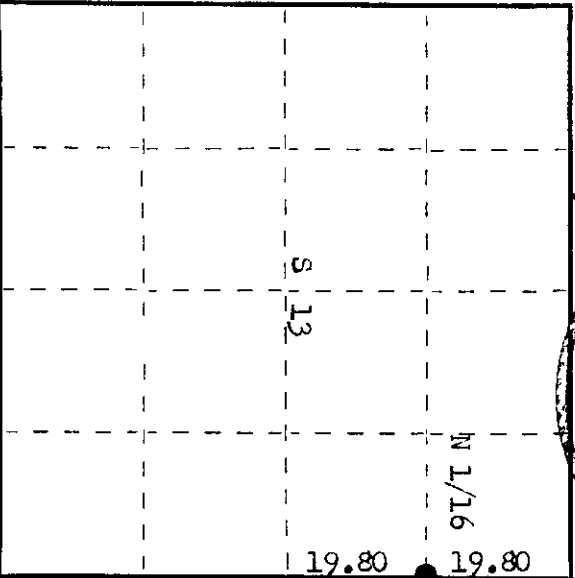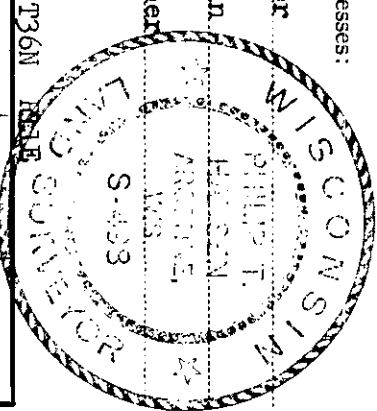

○ = Corner monument restored.

History of original corner establishment:

Corner established by H. C. Lawrence, Registered Land Surveyor, in 1950. He ran a random line South 3° 00' W. from Section Corner 7, 12, 18, 13 a distance of 79.20 chains to a point 7.00 chains west of Section Corner 13, 18, 19, 24. He set the N 1/16 corner at 19.80 chains equidistant between the NE corner and 1/4 corner. Set a 6" cedar post, from which Tamarack 8" bears N 67° W 56½ lks.

Description of corner evidence found:

Recovered H. C. Lawrence's 6" cedar post, squared and scribed N 1/16 S13, N 1/16 S18, down and laying under the snow. From H. C. Lawrence's calls on old random line, was able to locate area and recover corner. The point of post checked with bearing and distance from stump of Tamarack BT. BT was scribed N 1/16 S13 BT.

Description of monument and accessories I established to perpetuate the original location of this corner.

Replaced point of 6" cedar post with 1" OD iron pipe with 2" brass cap.
 Pipe projects 12" above ground. Cap stamped
 NBTs - Tamarack 6" North 32.3 lks scribed 1/16 BT.
 Tamarack 5" S 16° E 45.3 lks scribed 1/16 BT.
 Pipe and BTs painted blue.

R 11 N 1/16 131 18 12
 E T36N
 CPI-1975

Dated at Rhineland, Wis., this 23rd day of March, 1976

Signature Phillip T. Hansen Title Registered Land Surveyor Registration No. S-498
 (County Surveyor, Registered Land Surveyor, or other duly authorized official)

Office of Register of Deeds, County of Oneida I hereby certify that the within instrument was filed in this office for record on the 18th day of March, 1976 at 1:30 o'clock P. M.

Terrie Steege Trucken
 (Register of Deeds)

By: _____ Deputy

361133000