

CERTIFIED LAND CORNER RESTORATION



Index No. K-23

State of Wisconsin }
 County of Oneida } ss.

I Phillip T. Hansen, do hereby certify that on the 15th day of November, 1978, I found evidence of the NC 1/16 corner of Section 13 Township 36, North, Range 11 East, Fourth Principal Meridian, as described hereon; and that from this evidence I established a new monument and accessories as described hereon to perpetuate the original location of this corner.

Resident witnesses:

Glen Barker
Jim Claffin
Herb Wagoner

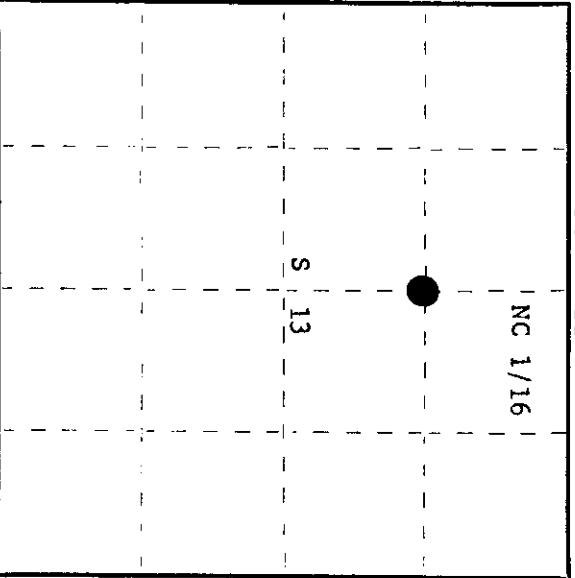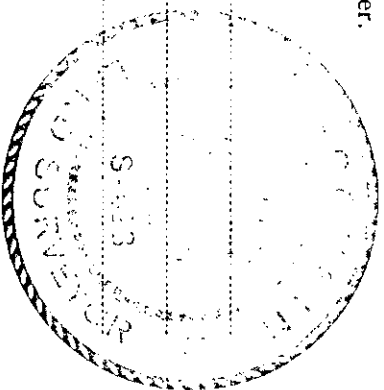

○ = Corner monument restored.

History of original corner establishment:

Corner established by H.C. Lawrence, Registered Land Surveyor, in 1950. He ran his E-W and N-S 1/4 lines to establish his C 1/4 corner which did not check out with one previously set by Dorr. He reasoned that Dorr had not run the E-W 1/4 line when he set his post. H.C. Lawrence set his NC 1/16 corner at 19.37 chains north of the C 1/4 corner equidistant between it and the N 1/4 corner.
 Marked NBT - Maple 16" S6°E, 54 links (no others near).
 Corner sets on the north side of a log road.

Description of corner evidence found:

Recovered H.C. Lawrence's 5" squared cedar post, scribed NC 1/16 S13, NC 1/16 S13.
 Recovered OBT - Maple 16" (18") S6°E 54 links, scribed NC 1/16 BT.

Description of monument and accessories I established to perpetuate the original location of this corner.

Replaced cedar post with 1 1/2" iron pipe with 2" brass cap, stamped:
 Monument projects 24" above ground.
 Marked NBT - Black Spruce 6" S36°W, 59.1 links
 scribed 1/16 BT.

S498
 T36N R11E
 NC 1/16 S13
 CP1-1978

Dated at Rhineland, Wis., this 11th day of December, 1978.

Signature Phillip T. Hansen Title Registered Land Surveyor Registration No. S-498
 (County Surveyor, Registered Land Surveyor, or other duly authorized official)

Office of Register of Deeds, County of Oneida
 Instrument was filed in this office for record on the 25th day of January, 1979 at 1:15 o'clock P. M.

Doris Verage Krehn
 (Register of Deeds)

By: _____ Deputy

040229