

CERTIFIED LAND CORNER RESTORATION



Index No. M-19

State of Wisconsin

County of Oneida } ss.

I Philip T. Hansen, do hereby certify that on the 7th day of January, 1975, I found evidence of the SC-1/16 corner of Section 14 Township 36 North, Range 11 East, Fourth Principal Meridian, as described hereon; and that from this evidence I established a new monument and accessories as described hereon to perpetuate the original location of this corner.

Resident witnesses:

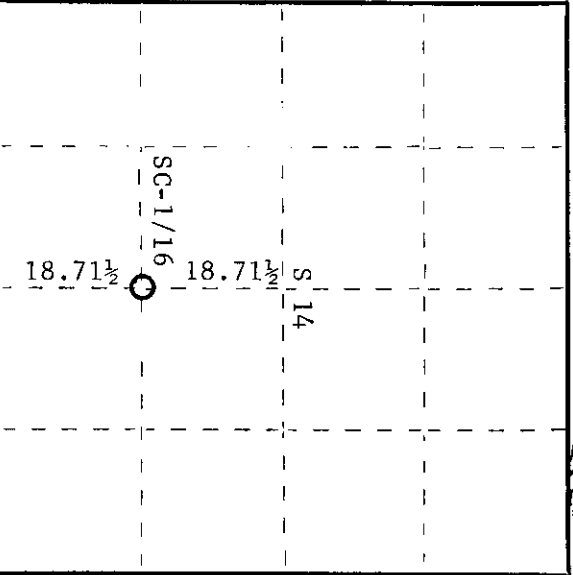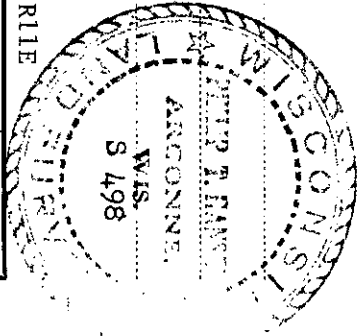

○ = Corner monument restored.

History of original corner establishment:

Corner established by H.C. Lawrence, Reg. Land Surveyor during his retracement survey of 1956. He ran the N-S 1/4 line from the N-1/4 corner to S-1/4 corner which he had established at 43.67 chains equidistant between the Sec. Corners, intersected at a point 79 lks. East. Ran E-W 1/4 line S88°30'E from 1/4 corner between 14 and 15. B.F. Dorr recovered 1/4 corner between Sections 13 and 14. Corrected lines to establish C-1/4 corner. SC-1/16 was established on corrected N-S 1/4 line equidistant between C-1/4 corner and S-1/4 corner at 18.71 1/2 chains.

Description of corner evidence found:

Recovered 4" tamarack post, squared and scribed S14 SC-1/16 in poor condition. No BT's were recovered.

Set 4" tamarack post
No BT's near this corner

Description of monument and accessories I established to perpetuate the original location of this corner.

Set 1" x 5' galvanized iron pipe with 2" brass cap stamped as follows -
NBT's Black spruce 12" N42W 103 1/2 lks. scribed 1/16 BT S498 T36N, R11E
No other trees available

SC-1/16 S 14
GPI-1975

Dated at Rhineland, Wis., this 16th day of June, 1975.

Signature: Philip T. Hansen Title: Registered Land Surveyor Registration No. S-498
County Surveyor, Registered Land Surveyor, or other duly authorized official)

Office of Register of Deeds, County of Oneida. I hereby certify that the within instrument was filed in this office for record on the 1st day of October, 1975 at 3:00 o'clock P. M.

Terrie Torrey Kuelsh
(Register of Deeds)

By: _____ Deputy

36114 1020