

CERTIFIED LAND CORNER RESTORATION

State of Wisconsin }  
County of Oneida } ss.

I, William E. Bandow, do hereby certify that on the 18th day of June, 1980, I found evidence of the North 1/4 corner of Section 22 Township 36 North, Range 11 East, Fourth Principal Meridian, as described hereon; and that from this evidence I established a new monument and accessories as described hereon to perpetuate the original location of this corner:

Description of original monument and accessories and subsequent restorations:


Corner set by Daugherty in 1859. West from NE corner 40.12 1/2 set post. No subsequent restorations on record.

Description of corner evidence found:

No evidence found. Ran North to CS 1/16 and Center 1/4 corner Section 15. Both were set by H.C. Lawrence in 1952. Corners were recovered, monumented with brass capped iron pipe and recorded by P. Hansen in 1975. Extended line south at Lawrence's distance to set 1/4 corner.

Description of monument and accessories I established to perpetuate the location of this corner:

Set Oneida County Aluminum Monument. No trees near. Set 1" iron pipe N 7°-36'-20"W 33.59'. Set 1" iron pipe S 7°-36'-20"E 33.59'

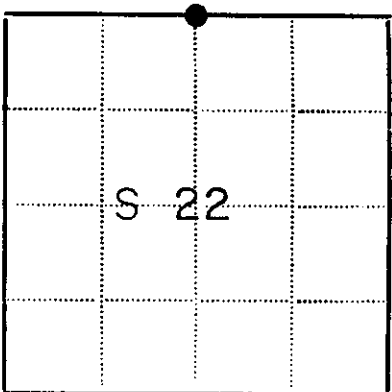

● - Corner monument restored  
□ -

Resident witnesses .....

Dated at Rhinelander Wisconsin, this 17th day of July 1980.

Signature *William E. Bandow* Title R.L.S.  
(County Surveyor, Registered Land Surveyor, or other duly authorized official)

Surveyors Registration No. S-1182

Office of Reg. of Deeds County of Oneida

I hereby certify that the within instrument was filed in this office for record on the 11 day of June 1980, and was filed in Book No. .... Page No. ... of County Records.

Signature *Donis Verage Kuhn* Title Reg. of Deeds  
*Cynthia O. Pitts* Deputy

Township ....., Range ....., Section ....., Index No. ...., Page No. ....

N-15