
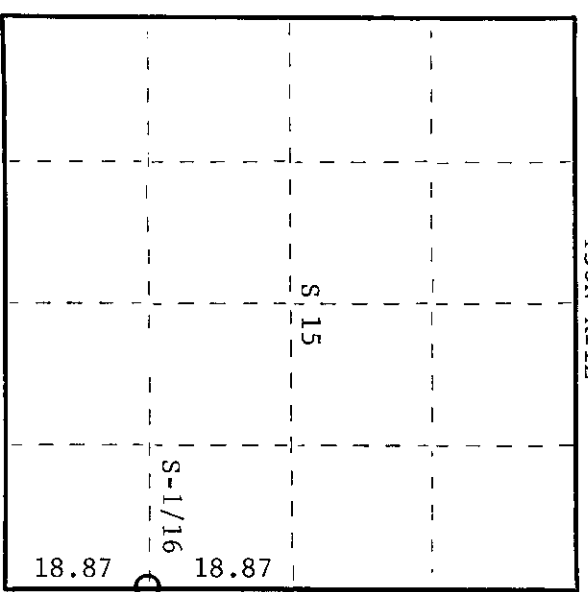


State of Wisconsin

County of Oneida } ss.

I Philip T. Hansen, do hereby certify that on the 27th day of January, 1975, I found evidence of the S-1/16 corner of between Section 14 and 15 Township 36, North, Range 11 E, Fourth Principal Meridian, as described hereon; and that from this evidence I established a new monument and accessories as described hereon to perpetuate the original location of this corner.

Resident witnesses:

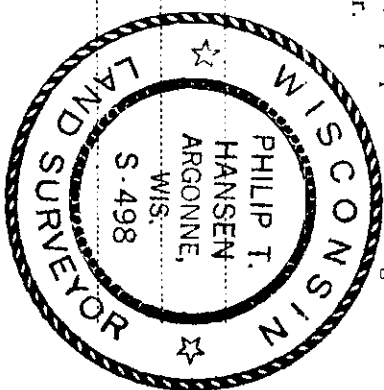

○ = Corner monument restored.

History of original corner establishment:

There are no old resurvey notes on record for line between Sec. 14 and 15. Section Corner 14-15-22 and 23 was set 89.74 chains north and 21.84 chains west of W-1/4 corner between Sec. 15 and 23 by H.C. Lawrence. Corner established by H.C. Lawrence, Registered Land Surveyor, during his retracement survey and subdivision survey dated 11/10/55. He ran a random line S2°E from Section Corner 14-15, 10 and 11, 75.48 chains to a point 48 links east of Section Corner. Set tamarack post at 56.61 chains and 36 links west.

No BT's available.

Description of corner evidence found:

Recovered 4" tamarack post, squared and scribed S-1/16 S14; S-1/16 S15 in fair condition.

No BT's recovered.

Description of monument and accessories I established to perpetuate the original location of this corner.

Replaced wooden post with 1-1/4"OD x 5' galvanized iron pipe w/brass cap stamped -

NBT's - Black spruce 10"	N39°W	31.3 links scribed 1/16 BT	5498
White birch 7"	S40°E	41 links scribed 1/16 BT	T36N R11E
		S-1/16	S15 S14
			CPI-1975

Dated at Rhineland, Wis., this 22 day of May, 1975.

Signature Philip T. Hansen Title Registered Land Surveyor Registration No. S-498
(County Surveyor, Registered Land Surveyor, or other duly authorized official)

Office of Register of Deeds, County of Oneida at 1st day of October, 1975.
I hereby certify that the within instrument was filed in this office for record on the 300 o'clock P. M.

Terrie Vantage Huelsh
(Register of Deeds)

By: _____ Deputy