

CERTIFIED LAND CORNER RESTORATION



Index No. **M-15**

State of Wisconsin

County of Oneida } ss.

I Philip T. Hansen do hereby certify that on the 27th day of January, 1975, I found evidence of the SC-1/16 corner of the Section 15 Township 36, North, Range 11 E, Fourth Principal Meridian, as described hereon; and that from this evidence I established a new monument and accessories as described hereon to perpetuate the original location of this corner.

Resident witnesses:

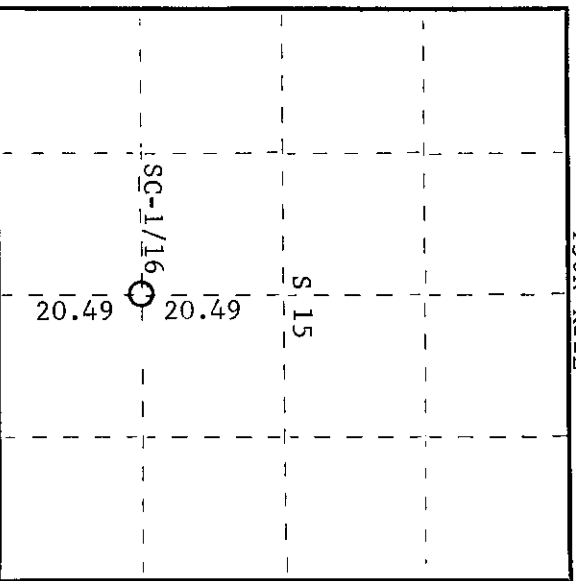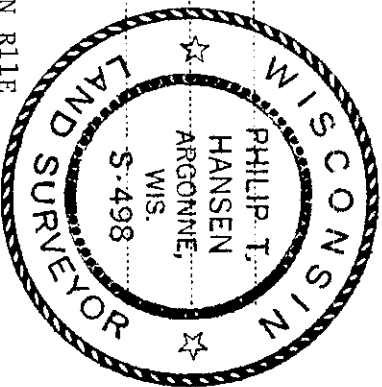

O = Corner monument restored.

History of original corner establishment:  
Corner established by H.C. Lawrence, Registered Land Surveyor, during his retracement survey and subdivision survey of 1955.

Set 4" tamarack post, equidistant between C-1/4 corner as established by intersection of N-S and E-W corrected 1/4 lines, at 20.49 chains. This corner is 10 links north and 13 links west of an old post of unknown origin.

No trees suitable for BT's.

Description of corner evidence found:

Recovered 4" tamarack post, squared and scribed SC-1/16 S15 in very poor condition. Point broke off in ground.

No BT's were recovered.

Description of monument and accessories I established to perpetuate the original location of this corner.  
Replaced tamarack post with 1-1/4"OD galvanized iron pipe w/2" brass cap stamped -

NBT - White spruce 16"      N89°E      147 links scribed 1/16 BT      S498  
 SC-1/16 S15      T36N R11E

CPI-1975

Dated at Rhineland, Wis., this 22 day of May, 1975

Signature Philip T. Hansen Title Registered Land Surveyor Registration No. S-498  
 (County Surveyor, Registered Land Surveyor, or other duly authorized official)

Office of Register of Deeds, County of Oneida. I hereby certify that the within instrument was filed in this office for record on the 1st day of October, 1975 at 3:00 o'clock P. M.

Donna Savage Tucker  
 (Register of Deeds)

By \_\_\_\_\_ Deputy