

CERTIFIED LAND CORNER RESTORATION



Index No. **L-17**

State of Wisconsin

County of Oneida } ss.

I, Philip T. Hansen, do hereby certify that on the 13th day of January, 1975, I found evidence of the 1/4 Corner corner of Sections 14 and 15 Township 36 North, Range 11 East, Fourth Principal Meridian, as described hereon; and that from this evidence I established a new monument and accessories as described hereon to perpetuate the original location of this corner.

Resident witnesses:

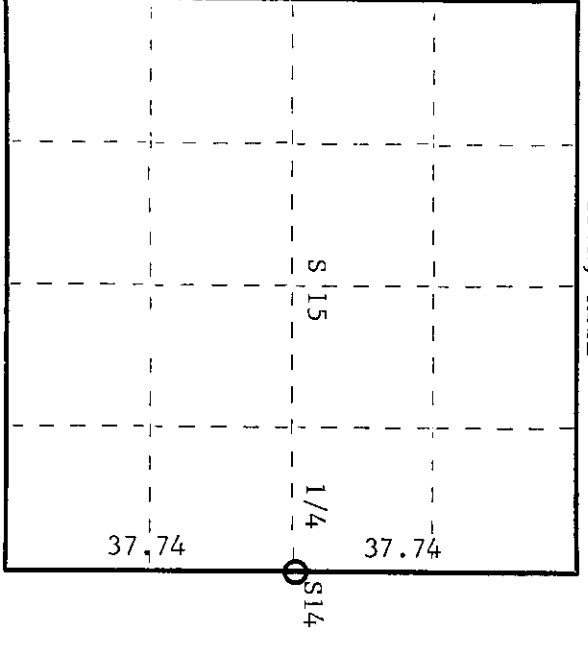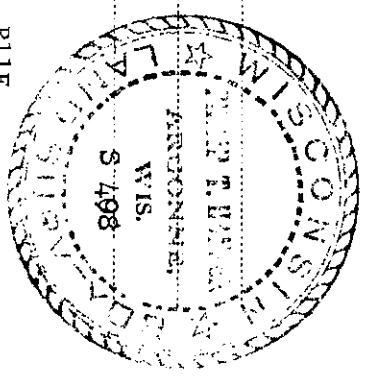

O = Corner monument restored.

CERTIFIED LAND CORNER RESTORATION

History of original corner establishment:

Original corner established by Wm. E. Dougherty, Gov. Deputy Surveyor in 1859.

Tamarack 7" S38E 13 lks.
Tamarack 9" N70W 28 lks.

No record of old resurvey notes on record for line between S14 and S15.

H.C. Lawrence, Registered Surveyor, retracement survey of 1955 states he ran a random line from corner of S10, 11, 14, and 15, South 20°E a distance of 75.48 chains to intersect South line a distance of 48 links West of corner. True line is S1°40'W. He set a 5" cedar post for 1/4 Corner 24 links West at rt. angles from 37.74 chains. No BT's established.

Description of corner evidence found:

Recovered H.C. Lawrence's 5" cedar post, squared and scribed S14 1/4; S15 1/4 in fair condition.

No BT's were recovered.

Description of monument and accessories I established to perpetuate the original location of this corner.

Set 2-1/2" x 5' galvanized iron pipe with brass cap stamped -

New BT. Cedar 10" S59W 101-1/2 lks. Scribed 1/4 BT T36N, R11E S498

S15 | S14
| 1/4

CPT-1975

Dated at Rhineland, Wis., this 16th day of June, 1975.

Signature *Philip T. Hansen* Title Registered Land Surveyor Registration No. S-498
(County Surveyor, Registered Land Surveyor, or other duly authorized official)

Office of Register of Deeds, County of Oneida, 1st day of October, 1975
at 3:00 o'clock P.M. I hereby certify that the within instrument was filed in this office for record on the 1st day of October, 1975

Doris Verage Fuchs
(Register of Deeds)

By Deputy