



CERTIFIED LAND CORNER RESTORATION

State of Wisconsin }
County of Oneida } ss.

I Philip T. Hansen, do hereby certify that on the 22nd day of January 1975, I found evidence of the EC-1/16 corner of Section 15 Township 36 North, Range 11 E, Fourth Principal Meridian, as described hereon; and that from this evidence I established a new monument and accessories as described hereon to perpetuate the original location of this corner.

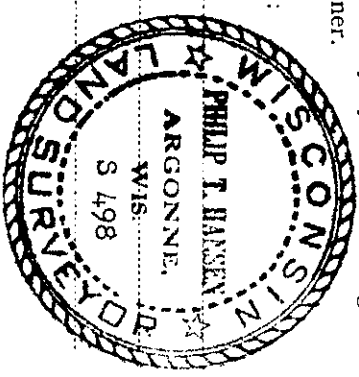

Resident witnesses:

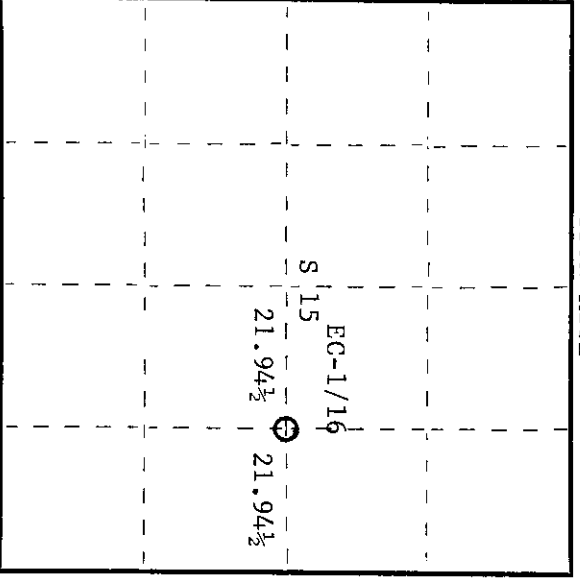

O = Corner monument restored.

History of original corner establishment:

Corner established by H.C. Lawrence, Registered Land Surveyor, during his retracement survey dated 1952. Set 4" squared and scribed cedar post, equidistant between his established C-1/4 corner and East 1/4 Section 15 at 21.94-1/2 chains.

BT's - Aspen 8" S49°W 32 links
Aspen 9" N35°E 24 links

Description of corner evidence found:

Recovered 4" cedar post, squared and scribed EC-1/16 S15 in fair condition.
No trace of aspen BT's.

Description of monument and accessories I established to perpetuate the original location of this corner.

Replaced wooden post with 1-1/4"OD x 5' galvanized iron pipe with 2" brass cap stamped -

NBT's - Elm 6" S29°W 26.2 links scribed 1/16 BT
White birch 9" N83°W 55.4 links scribed 1/16 BT

T36N R11E S498
EC-1/16 \$15
CPI-1975

Dated at Rhinelander, Wis., this 16th day of June, 1975.

Signature *Philip T. Hansen* Title Registered Land Surveyor Registration No. S-498
(County Surveyor, Registered Land Surveyor, or other duly authorized official)

Office of Register of Deeds, County of Oneida. I hereby certify that the within instrument was filed in this office for record on the 1st day of October, 1975 at 3:00 o'clock P.M.

Doris Savage Kuehn
(Register of Deeds)

By: Deputy

361152010