


CERTIFIED LAND CORNER RESTORATION


Index No. L-15

State of Wisconsin }
 County of Oneida } ss.

I, Philip T. Hansen, do hereby certify that on the 22nd day of January, 1975, I found evidence of the C-1/4 corner of Section 15 Township 36, North, Range 11 E, Fourth Principal Meridian, as described hereon; and that from this evidence I established a new monument and accessories as described hereon to perpetuate the original location of this corner.

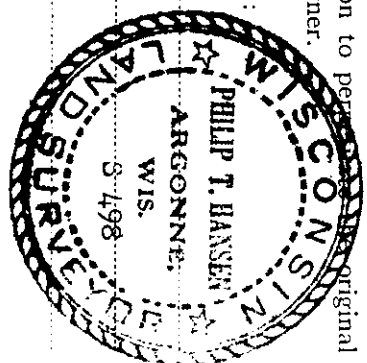

Resident witnesses:

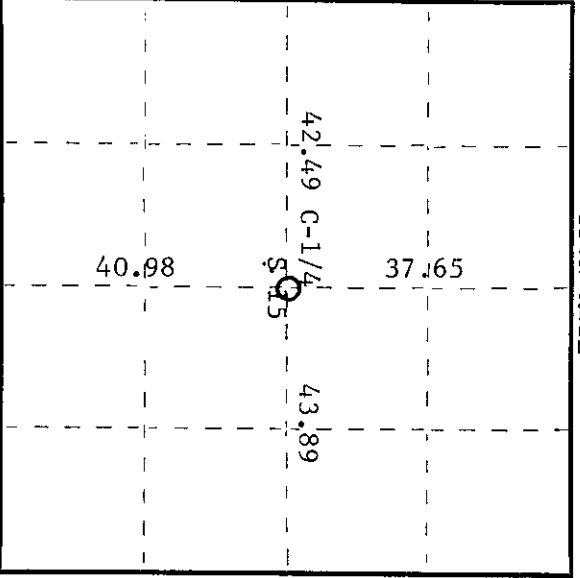

○ = Corner monument restored.

History of original corner establishment:

Corner established by H.C. Lawrence, Registered Land Surveyor, during his retracement survey of 1952.

There are no records to indicate that this corner had ever been set. Records note that he ran a random line west from established 1/4 corner between S14 and 15, 86.37 chains to intersect random line between S15 and 16, 1.22 chains north of 1/4 corner. He ran a N-S random line S0°35'E, intersect EW random line at 37.03 chains and south line at 79.00, at which point the 1/4 corner is 18 links west. Set C-1/4 corner at 37.65 chains S89°42'W of N-1/4 corner and 43.98 chains west of East 1/4 corner. BT's - Spruce 9", S27°E, 5 links.

Description of corner evidence found:
 Recovered 6" tamarack post, squared and scribed C-1/4S S15 in fair condition but it had fallen over and was covered with snow.

Recovered - Black spruce 9" S27°E 5 links scribed C-1/4S BT.

Description of monument and accessories I established to perpetuate the original location of this corner.
 Replaced wood stake with 2-1/2" x 5' galvanized iron pipe with brass cap stamped -

Established NBT - Black spruce 8" N78°E 70 links scribed C-1/4 BT.

S498
 T36N R11E
 C-1/4 \$15
 CPI-1975

Dated at Rhinelander, Wis., this 16th day of June, 1975.

Signature *Philip T. Hansen* Title Registered Land Surveyor Registration No. S-498
 (County Surveyor, Registered Land Surveyor, or other duly authorized official)

Office of Register of Deeds, County of Oneida, at 3:00 o'clock P.M. day of October, 1975. I hereby certify that the within instrument was filed in this office for record on the 1st day of October, 1975.

Doris Venage Kuehn
 (Register of Deeds)

By _____ Deputy