


CERTIFIED LAND CORNER RESTORATION

Index No. L-14

State of Wisconsin }  
 County of Oneida } ss.

I, Philip T. Hansen, do hereby certify that on the 28th day of January 1975, I found evidence of the WC-1/16 corner of Section 15 Township 36 North, Range 11 E, Fourth Principal Meridian, as described hereon; and that from this evidence I established a new monument and accessories as described hereon to perpetuate the original location of this corner.

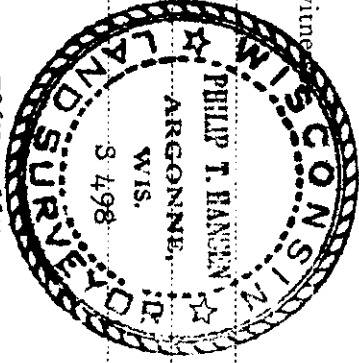

WC-1/16	21.24 1/2	21.24 1/2	S 15

○ = Corner monument restored.

History of original corner establishment:

Corner established by H.C. Lawrence, Registered Land Surveyor, during his retracement and subdivision survey of 1956.  
 Ran a random line N89°30'W from 1/4 corner between Sections 14 and 15, at 86.37 chains from which point the 1/4 corner between Sections 15 and 16 was 1.22 chains south.  
 Set WC-1/4 92 links south at right angles from 65.13-1/2 chains west of East 1/4 corner, 4" cedar post from which double elm 20" bears S47°E, 62 links; and elm 18" bears N5°E, 46 links.

Description of corner evidence found:

Recovered 4" cedar post, squared and scribed WC-1/16 S15 WC-1/16 S15 in fair condition.  
 Recovered - Double elm 20" S47°E 62 links scribing grown over  
 Elm 18" N5°E 46 links scribing grown over.

Description of monument and accessories I established to perpetuate the original location of this corner.

Replaced wood stake with 1-1/4"OD x 5' galvanized iron pipe w/brass cap stamped - S498  
 T36N R11E  
 WC-1/16 S15  
 No NBT's. CPT-1975

Dated at Rhinelander, Wis., this 16th day of June, 1975.

Signature *Philip T. Hansen* Title Registered Land Surveyor Registration No. S-498  
 (County Surveyor, Registered Land Surveyor, or other duly authorized official)

Office of Register of Deeds, County of Oneida, I hereby certify that the within instrument was filed in this office for record on the 1st day of October, 1975 at 3:00 o'clock P.M.

*Doris Verage Kuehn*  
 (Register of Deeds)

By: Deputy

36 N 15 R 11 E