# U.S. PUBLIC LAND SURVEY MONUMENT RECORD

Note: This form is intended and designed to fulfill all requirements of Wisconsin Administrative Code, Chapter A-E 7.08 U.S Public Land Survey Monument Record (3) (a) (b) (c) (d) (e) (f) (g) (h) (i). An additional sheet may be added if necessary to conform with said requirements.

(a) Corner location: Township 36 North

Range 11 East/West

Town/City/Village MONICO

County ONEIDA

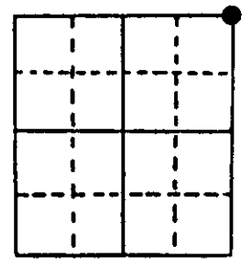

Section 21

(b) (f) (g) (h) Description of monument found at this corner and if it was accepted, state all evidence (material, testimonial, occupational, plats, records, other monuments) used as a basis for accepting. I not accepted or if nothing was found, state evidence used as basis for establishing location. I reestablished through lost corner proportionate methods, indicate all monuments, distances and directions used to establish. Indicate type of monument found or set and sign post.

1859- WOOD POST SET BY DAUGHERTY.
ORIGINAL B.T.'s 10" TAMARACK N 49° W 9 LKS.
10" TAMARACK S 88° E 11 LKS.

FOUND PERPETUATED CORNER USING W 1/16 SET BY BANDOW AND N 1/4 OF SECTION TO ESTABLISH CORNER LOCATION. (SEE BACK)

SET 1" X 24" IRON PIPE FLUSH IN ROAD BED.

(c) (d) (e) Plan view of corner with ties to at least 4 witness monuments. If in disagreement with previously established corner, show the distances between the two corners and also indicate the ties to the disputed corner.

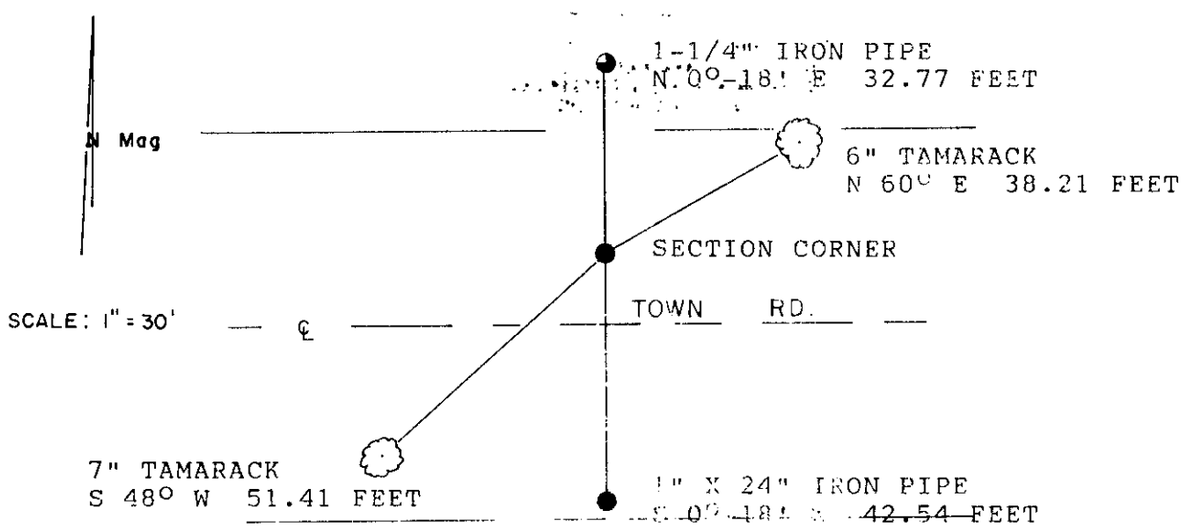


BEARING TREE MEASUREMENTS ARE TO ALUMINUM NAIL IN SIDE OF TREE.

(i) I, KIP W. SODER S-1731 (type or print name) certify that the corner location on this record was determined by me or under my direction and control and that this U.S. Public Land Survey Monument Record is correct and complete to the best of my knowledge and belief.

Kip W. Soder 5/11/98

Signature Date

WISCONSIN KIP W. SODER S-1731 THREE LAKES, WI LAND SURVEYOR

Stamp

36 / 11 / 21 / 16 0000

Index No. N 13

1980 SURVEY BY BANDOW (B1167, B2124) USES MONUMENT AT THIS POSITION ALONG WITH THE N 1/4 CORNER OF SECTION 22 TO ESTABLISH W 1/16. USING THE N 1/4 OF SECTION 22, THE W 1/16 SET BY BANDOW SHOWING A TIE TO THE SECTION CORNER AND THE N 1/4 OF SECTION 21 THE SECTION CORNER POSITION WAS REESTABLISHED.

REGISTER OF DEEDS OFFICE
ONEIDA COUNTY, WIS.
JUN - 1 1996
At _____ O'clock _____
THOMAS H. LEIGHTON
REGISTER OF DEEDS