

CERTIFIED LAND CORNER RESTORATION

Index No. M-11


State of Wisconsin }
 County of Oneida } ss.

I, Phillip T. Hansen, do hereby certify that on the 19th day of March, 1975, I found evidence of the SC-1/16 corner of Section 16


Township 36, North, Range 11 East, Fourth Principal Meridian,

as described hereon; and that from this evidence I established a new monument and accessories as described hereon to perpetuate the original location of this corner.

Resident witnesses:

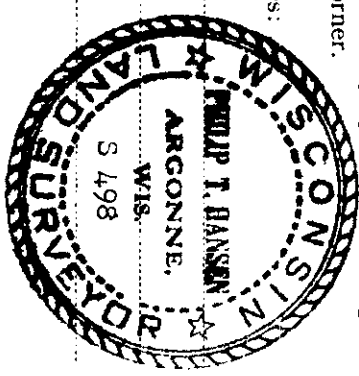

T36N R11E

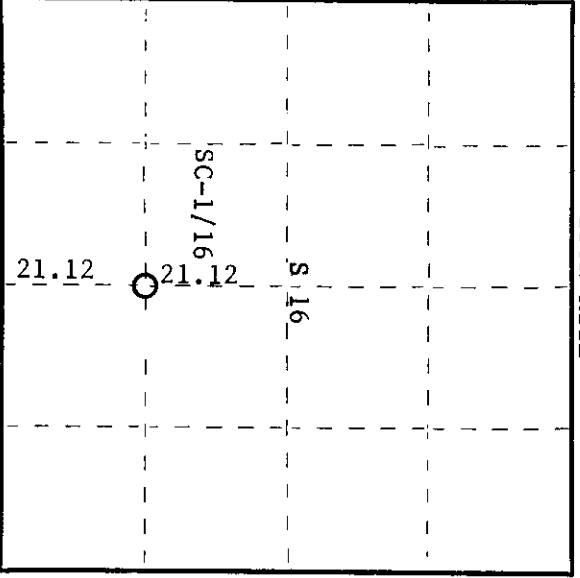

○ = Corner monument restored.

History of original corner establishment:

Original corner established by B.F. Dorr, County Surveyor, in 1898. Corner recovered by H.C. Lawrence, Registered Land Surveyor, in 1946. His notes state that he found Dorr's stake, broken off and lying on the ground. He also found stump of Dorr's tamarack BT N82½E, 18 links. Set new post in old hole. Distance south of C¼ corner is 21.12 chains. Distance to south ¼ post is 21.12 chains.

Description of corner evidence found:

Recovered 4" tamarack post, squared, and scribed SC-1/16 S16 in poor condition. Post broken off at ground level.

No signs of old tamarack stump.

Description of monument and accessories I established to perpetuate the original location of this corner.

Iron pipe 1¼" OD x 5' iron pipe w/2" brass cap was set ½ link immediately south of point of old stake, which we were unable to get out of the ground. Brass cap is stamped -

NBT's - black spruce 6" S40°E 36.2 links scribed 1/16 BT S498
 tamarack 6" N23°W 23.6 links scribed 1/16 BT T36N R11E

SC-1/16 S 16
 CPI-1975

Dated at Rhinelander, Wis., this 16th day of June, 1975.

Signature: *Phillip T. Hansen* Title: Registered Land Surveyor Registration No. S-498
 (County Surveyor, Registered Land Surveyor, or other duly authorized official)

Office of Register of Deeds, County of Oneida. On this 1st day of October, 1975, I hereby certify that the within instrument was filed in this office for record on the 300 o'clock M.

Tommy George Tushnet
 (Register of Deeds)

By: _____ Deputy

361116 1020