

CERTIFIED LAND CORNER RESTORATION

Index No. L-11

State of Wisconsin

County of Oneida } ss.

History of original corner establishment:  
Original corner established by B.F. Dorr, County Surveyor, in 1898.


White pine 8" N28W 13 links  
White pine stump 24" W 6 1/2 links

Recovered and remarked by H.C. Lawrence, Registered Land Surveyor, in 1946. He ran the 1/4 line south from 1/4 corner between S9 and S16, 41.50 chains, at which point Dorr's 1/4 corner was 3.83 chains east, at right angles. He set new 4" cedar post in old posthole and rescribed the bearing trees. The standing BT is visible from Highway 45.

I, Phillip T. Hansen, do hereby certify that on the 7th day of February, 1975, I found evidence of the corner of Section 16, Township 36 North, Range 11 East, Fourth Principal Meridian, as described hereon; and that from this evidence I established a new monument and accessories as described hereon to perpetuate the original location of this corner.

Description of corner evidence found:  
Recovered Lawrence's 4" cedar post, squared and scribed C-1/4 S16 in poor condition.  
Recovered white pine 8" (now 26"), scribed BT N28°W, 13 links. Pine stump now visible but very rotted.

Resident witnesses:

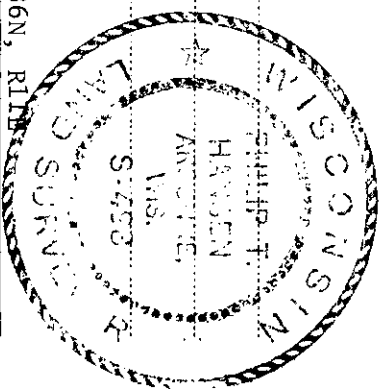


T36N, R11E

Description of monument and accessories I established to perpetuate the original location of this corner.  
Replaced old stake with 2-1/2" x 5' galvanized iron pipe with brass cap stamped -

NBT - White birch 9" S35°E 81.3 links scribed C-1/4 BT

C-1/4 S+16

GPI-1975

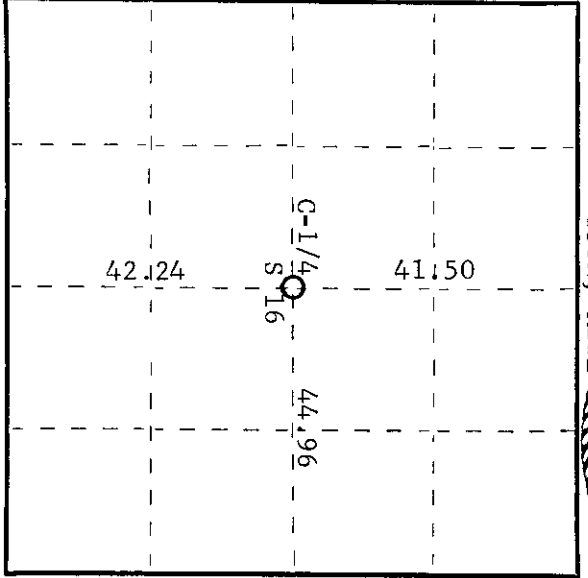

○ = Corner monument restored.

Dated at Rhinelander, Wis., this 16th day of June, 1975.

Signature: *Phillip T. Hansen* Title: Registered Land Surveyor Registration No. S-498  
(County Surveyor, Registered Land Surveyor, or other duly authorized official)

Office of Register of Deeds, County of Oneida. I hereby certify that the within instrument was filed in this office for record on the 1st day of October, 1975 at 3:00 o'clock P.M.

Signature: *Dorrie Temple Fuchs*  
(Register of Deeds)

By: Deputy

0201162020