CERTIFIED LAND CORNER RESTORATION

Index No. K-13

State of Wisconsin
County of Oneida } ss.

I Philip T. Hansen, do hereby certify that on the 23rd day of January, 19 75, I found evidence of the N-1/16 corner of between Sec. 15 and 16 Township 36, North, Range 11 E, Fourth Principal Meridian, as described hereon; and that from this evidence I established a new monument and accessories as described hereon to perpetuate the original location of this corner.

Resident witnesses:

WISCONSIN
PHILIP T. HANSEN
ARGONNE, WIS.
S-498
LAND SURVEYOR

History of original corner establishment:

Original corner established by H.C. Lawrence, Registered Land Surveyor, in 1947. He ran S2°00'W on someone's old random line. He came 2.70 links west of B.F. Dorr's 1/4 corner at 37.94 chains, at that time he set the N-1/16 corner 1.35 chains east at 18.97 chains equidistant measure.

Resurvey in 1952, he ran S2°00E at 19.00 chains the old N-1/16 was 22 links west at 37.90 chains, Dorr's 1/4 post is 34 links west at right angles. Reset N-1/16 17 links west of 18.95. This was 5 links east and 5 links north of its old position. Set 4" cedar post, squared and scribed.

Description of corner evidence found:

Recovered 4" cedar post, squared and scribed N-1/16 S15; N-1/16 S16 in good condition.

No old bearing trees recovered.

Description of monument and accessories I established to perpetuate the original location of this corner.

Replaced wooden post with 1-1/4"OD x 5' galvanized iron pipe w/brass cap stamped -

S498
T36N R11E
N-1/16 S16 | S15
CPI-1975

NBT's -	White birch 10"	N89°E	39.5	links scribed 1/16 BT
	Red maple 7"	S82°W	63	links scribed 1/16 BT

T36N R11E

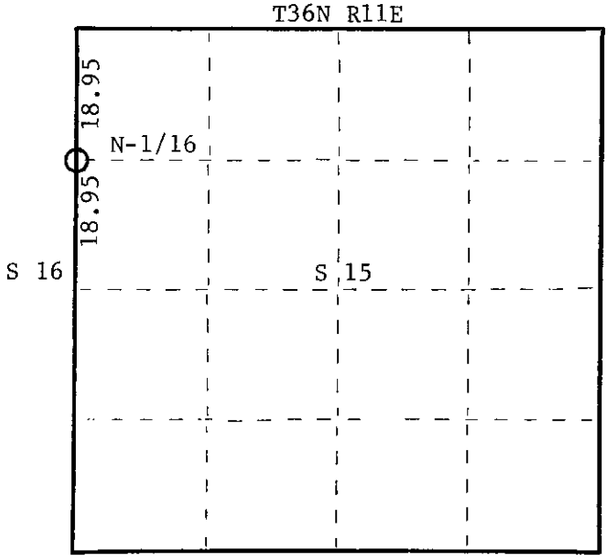

○ = Corner monument restored.

Dated at Rhinelander, Wis., this 22 day of May, 19 75

Signature Philip T. Hansen Title Registered Land Surveyor Registration No. S-498
(County Surveyor, Registered Land Surveyor, or other duly authorized official)

Office of Register of Deeds, County of Oneida, I hereby certify that the within instrument was filed in this office for record on the 1st day of October, 19 75 at 3:00 o'clock P. M.

Doris Verege Kuehn
(Register of Deeds)

By ..... Deputy

FORM 985 H. C. MILLER CO., MILWAUKEE

36116 3000