

CERTIFIED LAND CORNER RESTORATION



Index No. K-12

State of Wisconsin }  
County of Oneida } ss.

I Phillip T. Hansen, do hereby certify that on the 15th day of November, 1978, I found evidence of the NE 1/16 corner of Section 16 Township 36, North, Range 11 East, Fourth Principal Meridian,

as described hereon; and that from this evidence I established a new monument and accessories as described hereon to perpetuate the original location of this corner.

Resident witnesses:  
Glen Barker  
Jim Clafflin  
Herb Wagoner

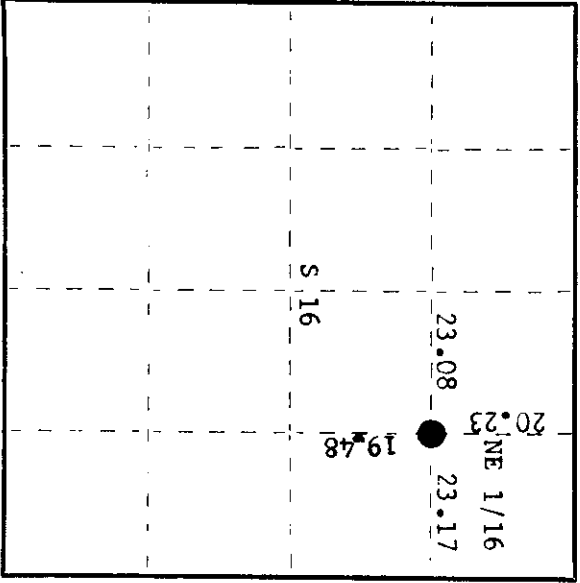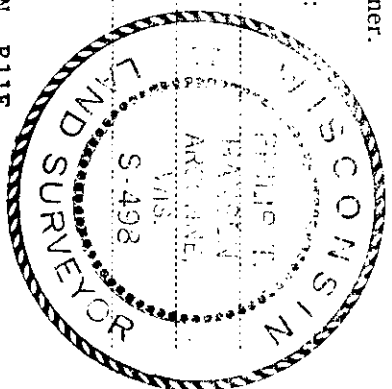

History of original corner establishment:

Corner established by H.C. Lawrence, Registered Land Surveyor, in 1952. Ran S 3° 45' E from E 1/16 between 9 and 16 39.71 chains to close out 65 links west of EC 1/16. Also ran N 88° 20' E from NC 1/16 46.25 chains to close out N 1/16 corner. Established NE 1/16 corner at 20.23 chains south of E 1/16 and 23.08 chains east of NC 1/16 corner.

Description of corner evidence found:  
Recovered 4" squared cedar post, scribed NE 1/16 S16 in very poor condition.  
Recovered an OBT - Yellow Birch 12" N43°W, 15.8 links - a 15' stub, scribed BT.  
No notes available on this BT.

Description of monument and accessories I established to perpetuate the original location of this corner.  
Replaced cedar post with 1 1/2" iron pipe with 2" brass cap, stamped:  
Monument projects 24" above ground.  
Marked NBT's - Maple 7" N70°W, 17 links  
Maple 7" N19°W, 37.8 links, scribed 1/16 BT.

S498  
T36N R11E  
NE 1/16 S 16  
CP1-1978

Dated at Rhineland, Wis., this 11th day of December, 1978

Signature Phillip T. Hansen Title Registered Land Surveyor Registration No. S-498  
(County Surveyor, Registered Land Surveyor, or other duly authorized official)

Office of Register of Deeds, County of Oneida  
Instrument was filed in this office for record on the 18th day of January, 1979  
at 1:00 o'clock P. M.

Doris W. Savage Kuehn  
(Register of Deeds)

By: \_\_\_\_\_ Deputy