

CERTIFIED LAND CORNER RESTORATION

Index No. N-7

State of Wisconsin


County of Oneida } ss.

I, Phillip T. Hansen, do hereby certify that on the 12th day of February, 1979, I found evidence of the Quarter corner of Sections 17 and 20 Township 36, North, Range 11 East, Fourth Principal Meridian, as described hereon, and that from this evidence I established a new monument and accessories as described hereon to perpetuate the original location of this corner.


Resident witnesses:

Jim Claffin

Herb Wagoner

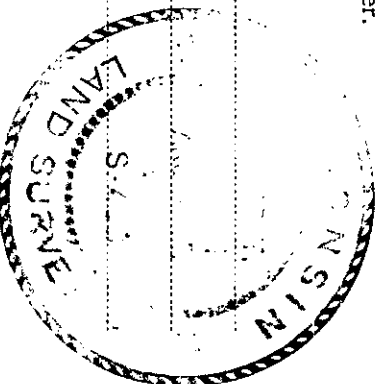

T36N R11E

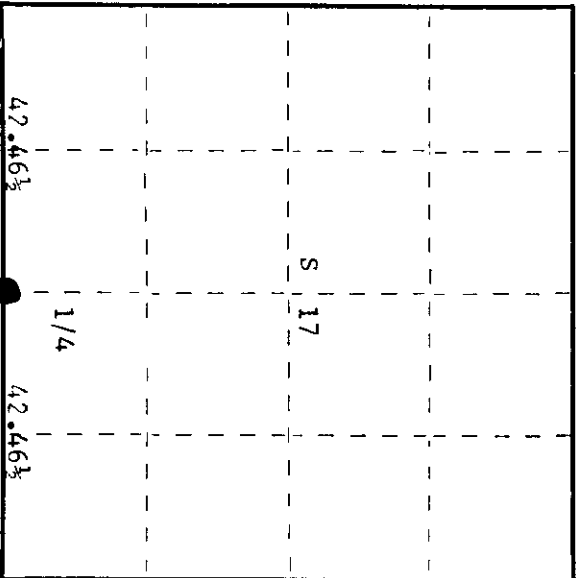

○ = Corner monument restored.

History of original corner establishment:

Original corner established by Wm. E. Dougherty, Deputy Surveyor, in 1859 from which Sugar 12" bears S 5° E 10 links and Hemlock 6" bears N 40° W 9 links.

Corner re-established by N. Loftus, Ripco Surveyor, in 1958. Ran random line bearing 90° magnetic from section corner 17, 18, 19 and 20, 84.93 chains to close out 1.21 chains north of section corner. Corrected bearing S 89° 11' E. Set 1/4 corner at 42.46 3/4 chains intermediate.

Marked NBT's -

Birch 8" N55°W 39 1/2 links

Sugar Maple 8" S3°E 7 1/2 links

Description of corner evidence found:

Recovered Ripco's 2" iron pipe with 4" square brass cap in good condition and securely set. Recovered OBT's -

Yellow Birch 8" N55°W 30.25 links, now a rotted stump.

Sugar Maple 8" (10") S3°E (S5°E) 7.5 links, scribbling grown over.

Brass cap stamped:

T36N R11E
S 17
1/4 S+20
RIFCO

Description of monument and accessories I established to perpetuate the original location of this corner.

As monument was recovered in good condition, it was left in place.

Monument projects 24" above ground.

Marked NBT's -

Sugar 10" S56°W 5.7 links

Sugar 8" S61°E 64.0 links

Sugar 5" N52°W 66.7 links

all scribed 1/4 BT.

Dated at Rhinelander, Wis., this 28th day of February, 19 79.

Signature: Phillip T. Hansen Title: Registered Land Surveyor Registration No. S-498

(County Surveyor, Registered Land Surveyor, or other duly authorized official)

Office of Register of Deeds, County of Oneida, 63rd day of March, 19 79.

at 3:30 o'clock P. M.

Loraine Virginia Fischer
(Register of Deeds)

By Phillip T. Hansen Deputy

200070036