

CERTIFIED LAND CORNER RESTORATION

Index No. M-9

State of Wisconsin



County of Oneida } ss.

I Phillip T. Hansen, do hereby certify that on the 12th day of February, 1979, I found evidence of the S 1/16 corner of Sections 16 & 17 Township 36, North, Range 11 East, Fourth Principal Meridian, as described hereon; and that from this evidence I established a new monument and accessories as described hereon to perpetuate the original location of this corner.

Resident witnesses:

Jim Claflin

Herb Wagoner

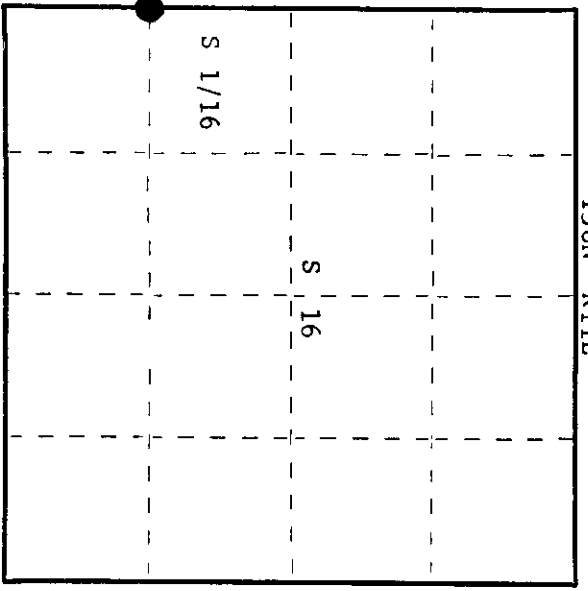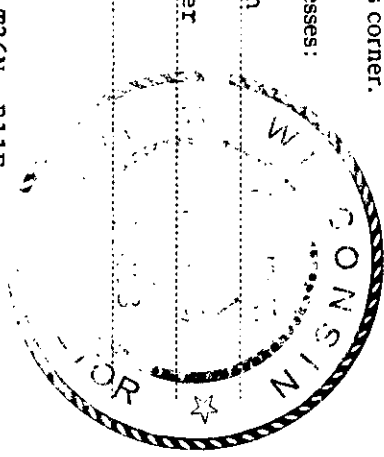

○ = Corner monument restored.

CERTIFIED LAND CORNER RESTORATION

History of original corner establishment: Corner established by B.F. Dorr, County Surveyor, in 1906. BT Sugar 7" N62°W 31-3/4 links. Corner recovered by H.C. Lawrence, Registered Land Surveyor, in 1948. Found Dorr's old post badly rotted with scribe marks 1/85 on it. Found old sugar stub standing full of scars and cat faces, it was N62°W, 34 links. Set new 5" cedar post and marked NBT. Sugar 16" N2°E 22 links. Yellow Birch 18" S44°W 53 1/2 links.

Description of corner evidence found:

Recovered H.C. Lawrence's 5" squared cedar post standing in poor condition, scribed S 1/16 - S17 - S 1/16 - S16.  
Recovered NBT -  
Sugar 16" (20") N 2° E 22 links

Description of monument and accessories I established to perpetuate the original location of this corner.  
Replaced post with a 1 1/2" iron pipe with 2" brass cap projecting 24" above ground.

Marked NBT - S498  
Sugar 6" S83°W 15.5 links T36N R11E  
scribed 1/16 BT S 1/16 S17 + S16  
CPI-1979

Dated at Rhineland, Wis., this 22nd day of February, 1979

Signature [Signature] Title Registered Land Surveyor Registration No. S-498  
(County Surveyor, Registered Land Surveyor, or other duly authorized official)

Office of Register of Deeds, County of Oneida, I hereby certify that the within instrument was filed in this office for record on the 13th day of March, 1979 at 1:30 o'clock P. M.

[Signature]  
(Register of Deeds)

By [Signature] Deputy

3611171000