

CERTIFIED LAND CORNER RESTORATION

Index No. L-9

State of Wisconsin



County of Oneida } ss.

I, Phillip T. Hansen, do hereby certify that on the 4th day of April, 1980, I found evidence of the Quarter corner of Sections 16 and 17 Township 36, North, Range 11 East, Fourth Principal Meridian, as described hereon; and that from this evidence I established a new monument and accessories as described hereon to perpetuate the original location of this corner.

Resident witnesses:

Jim Claflin

Herb Wagoner

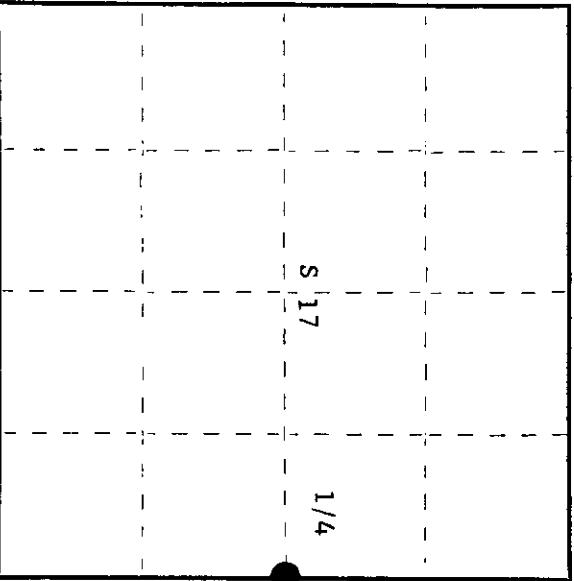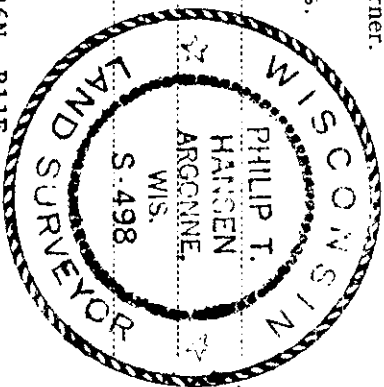

○ = Corner monument restored.

History of original corner establishment:

Original corner established by Wm. E. Dougherty, Deputy Surveyor, in 1859, from which white spruce 10" bears N 85° E 29 links and cedar 12" bears N 50° W 11 links. Corner recovered by B.F. Dorr, county surveyor, in 1898. Set new post and marked NBT's - Cedar 13" N77½° E 16-1/2 links and cedar 5" S56° W 10 links. Corner recovered by H.C. Lawrence, Registered Land Surveyor, in 1946. Recovered point of Dorr's post and his BT's. Set new post.

Description of corner evidence found:

Recovered Lawrence's cedar post still standing but in very poor condition., scribed 1/4 S17, S16.  
 Recovered OBT's - Cedar 18" N77° E 16.5 links, scribe marks still visible (now dead).  
 Cedar 5" S56° W 14.0 links  
 H.C. Lawrence's Cedar 14" N2° W 29.3 links, scribed 1/4S NBT.

Description of monument and accessories I established to perpetuate the original location of this corner.

Replaced H.C. Lawrence's wood post with 2-1/2" Berntsen A-1 Federal Monument projecting 12" above ground. Cap stamped:

Marked NBT's -  
 Cedar 8" S42° E 20.0 links, scribed 1/4 BT. T36N R11E  
 Black Ash 8" S23° E, 24.0 links, scribed 1/4 BT. 1/4 17 + 16  
 Black Ash 6" N44° E, 10.2 links, scribed 1/4 BT. S498 - 1980

Dated at Rhineland, Wis., this 19th day of May, 1980

Signature Phillip T. Hansen, Title Registered Land Surveyor, Registration No. S-498  
 (County Surveyor, Registered Land Surveyor, or other duly authorized official)

Office of Register of Deeds, County of Oneida. I hereby certify that the within instrument was filed in this office for record on the 5th day of June, 1980 at 1:30 o'clock P. M.

Terri Neage Kuehn  
 (Register of Deeds)

By Terri Neage Kuehn Deputy

361174000