

CERTIFIED LAND CORNER RESTORATION



Index No. L-7

State of Wisconsin }
 County of Oneida } ss.

I Philip T. Hansen, do hereby certify that on the 19th day of January, 1979, I found evidence of the C 1/4 corner of Section 17 Township 36, North, Range 11 East, Fourth Principal Meridian, as described hereon; and that from this evidence I established a new monument and accessories as described hereon to perpetuate the original location of this corner.

Resident witnesses:

- Glen Barker
- Jim Clafin
- Herb Wagoner

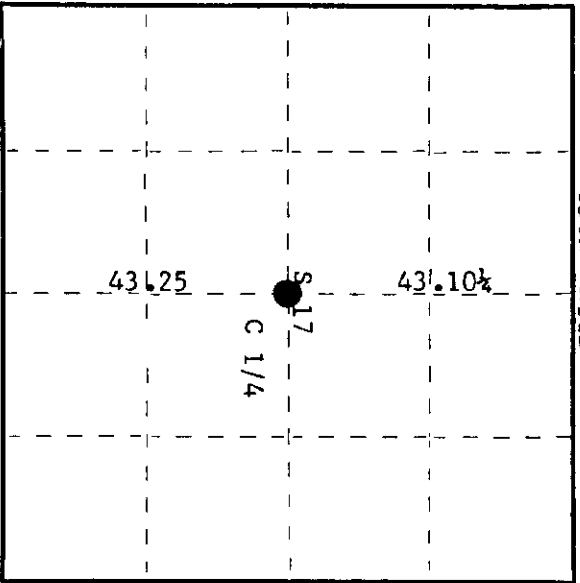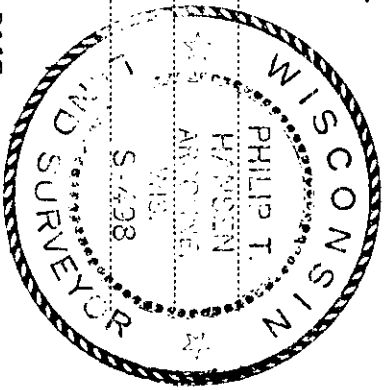

○ = Corner monument restored.

CERTIFIED LAND CORNER RESTORATION

History of original corner establishment:

Corner established by N. Loftus, Ripco Surveyor, in 1958. Ran N-S and E-W 1/4 lines from previously recovered 1/4 corners to establish this C 1/4 corner. Corner established at 43.25 chains N 8° 58' W of S 1/4 corner and 43.10½ chains S 8° 58' E of N 1/4 corner. Marked NBT's - Cedar 6" S13°W 38½ links Cedar 6" N46°E 43 links

Description of corner evidence found:

Recovered 8" squared cedar post, 9½' high, scribed C 1/4 S17, lying on the ground. Recovered OBT's - Cedar 6" (8") S13°W 38.5 links, scribed C 1/4 S17, BT. Cedar 6" (8") N46°E 43 links, scribed C 1/4 S17 BT.

Description of monument and accessories I established to perpetuate the original location of this corner. Set 2½" Berntsen A-1 Federal Monument (CPI) in place from calls to recovered BT's. Monument projects 18" above ground. Cap stamped: Marked NBT - Cedar 10" N46°W 63 links, scribed C 1/4 BT.

T36N R11E
 C 1/4 S 17
 S498 - 1979

Dated at Rhineland, Wis., this 31st day of January, 1979

Signature Philip T. Hansen Title Registered Land Surveyor Registration No. S-498
 (County Surveyor, Registered Land Surveyor, or other duly authorized official)

Office of Register of Deeds, County of Oneida I hereby certify that the within instrument was filed in this office for record on the 17th day of February, 1979 at 1:30 o'clock P. M.

Dore Berger, Treche
 (Register of Deeds)

By: _____ Deputy