

CERTIFIED LAND CORNER RESTORATION

Index No. K-9

State of Wisconsin



County of Oneida } ss.

I Phillip T. Hansen, do hereby certify that on the 4th day of April, 19 80, I found evidence of the N 1/16 corner of Sections 16 and 17 Township 36, North, Range 11 East, Fourth Principal Meridian, as described hereon; and that from this evidence I established a new monument and accessories as described hereon to perpetuate the original location of this corner.

Resident witnesses:

Jim Clafflin

Herb Wagoner

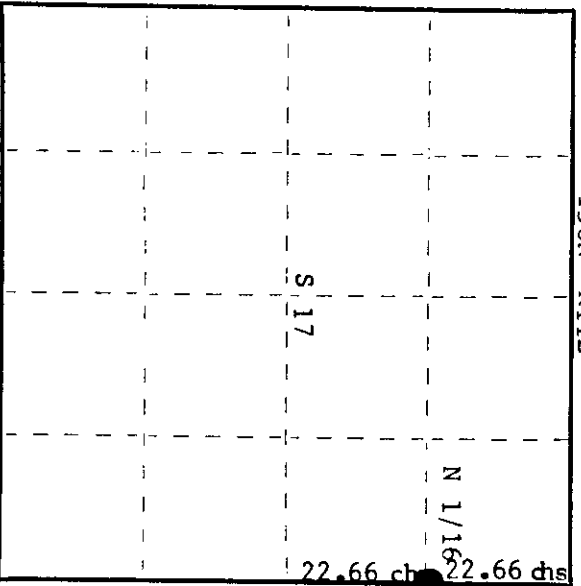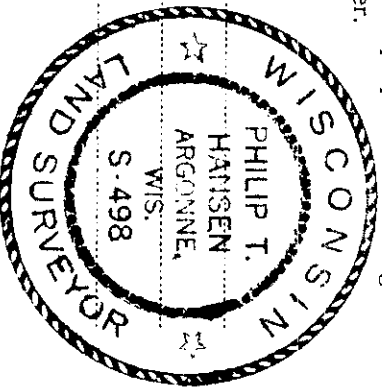

○ = Corner monument restored.

History of original corner establishment:

Corner established by Goddard and crew, Ripco surveyors, in 1953. Ran random line south bearing 171° from section corners 8, 9, 17, 16 45.32 chains to close out 86.5 links west of E 1/4 corner. Set the N 1/16 at 22.66 chains 43.25 links east. Corrected bearing S 10° 06' E. Marked NBT's -
Black Spruce 4" S5°E 27 links
Balsam 5" N86°W 37 links

Description of corner evidence found:

Recovered Ripco's 3" squared spruce stake, surrounded by rock cairn.
Recovered OBT's -
Black Spruce 4" S5°E 27.0 links, scribed N 1/16 BT (now dead).
Balsam 5" N86°W (N79°W) 37.0 links, scribed N 1/16 BT.

Description of monument and accessories I established to perpetuate the original location of this corner.

Set a 1-1/2" iron pipe in place of wood post. This area is all large ledge rock which did not permit putting it in the ground. Placed a large rock cairn around base of iron pipe. Brass cap stamped:
Marked NBT's - Black Spruce 6" S25°W 44.2 links
Black Spruce 6" S45°E 49.1 links
both scribed 1/16 BT.
S498
T36N R11E
N 1/16 S17+S16
CPI-1980

Dated at Rhinelander, Wis., this 19th day of May, 19 80

Signature Phillip T. Hansen Title Registered Land Surveyor Registration No. S-498
(County Surveyor, Registered Land Surveyor, or other duly authorized official)

Office of Register of Deeds, County of Oneida I hereby certify that the within instrument was filed in this office for record on the 5th day of June, 19 80 at 1:30 o'clock P. M.

Doris Savage Kuehn
(Register of Deeds)

By: _____ Deputy