

CERTIFIED LAND CORNER RESTORATION

Index No. K-8

State of Wisconsin

County of Oneida


ss.

I Phillip T. Hansen, do hereby certify that on the 2nd day of April, 19 80, I found evidence of the NE 1/16 corner of Section 17 Township 36, North, Range 11 East, Fourth Principal Meridian, as described hereon; and that from this evidence I established a new monument and accessories as described hereon to perpetuate the original location of this corner.


Resident witnesses:

Jim Clafflin

Herb Wagoner

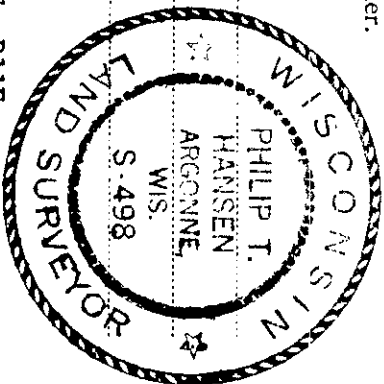

T36N R11E

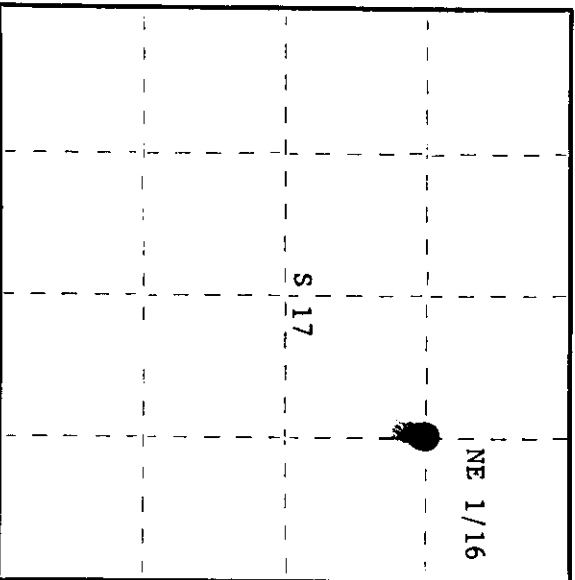

○ = Corner monument restored.

CERTIFIED LAND CORNER RESTORATION

History of original corner establishment:

Corner established by N. Loftus, Ripco surveyor, in 1959. Ran random line east from previously established NC 1/16, bearing 87° 10' a distance of 40.85-1/4 chains to close out 19-1/2 links south of N 1/16. Set NE 1/16 at 20.426 chains, corrected bearing N 86° 54' E. Marked NBT's - Cedar 14" N44°W 26 links W.Spruce 3" S50°E 38-1/2 links

Description of corner evidence found:

Recovered Ripco's BT's - Cedar 14" (16") N44°W 26.0 links and W.Spruce 3" (7") S50°E 38.5 links. No evidence of corner recovered. Determined point from intersection of BT's.

Description of monument and accessories I established to perpetuate the original location of this corner.

Set a 1-1/2" iron pipe with 2" brass cap, stamped: Monument projects 24".

Placed a rock cairn around base of monument.

Marked NBT's - B.Spruce 7" S67°W 58.0 links, scribed 1/16 BT.

T36N R11E
NE 1/16 S 17
S498 - 1980

Dated at Rhineland, Wis. this 19th day of May, 19 80

Signature Phillip T. Hansen Title Registered Land Surveyor Registration No. S-498
(County Surveyor, Registered Land Surveyor, or other duly authorized official)

Office of Register of Deeds, County of Oneida I hereby certify that the within instrument was filed in this office for record on the 5th day of June, 19 80 at 1:30 o'clock P. M.

Doree Leverage Kuehn
(Register of Deeds)

By: _____ Deputy

361173010