

CERTIFIED LAND CORNER RESTORATION

Index No. K-7

State of Wisconsin } ss.  
County of Oneida



I, Phillip T. Hansen, do hereby certify that on the 19th day of January, 1979, I found evidence of the NC 1/16 corner of Section 17 Township 36, North, Range 11 East, Fourth Principal Meridian, as described hereon; and that from this evidence I established a new monument and accessories as described hereon to perpetuate the original location of this corner.

Resident witnesses:

Glen Barker

Jim Clafflin

Herb Makoner

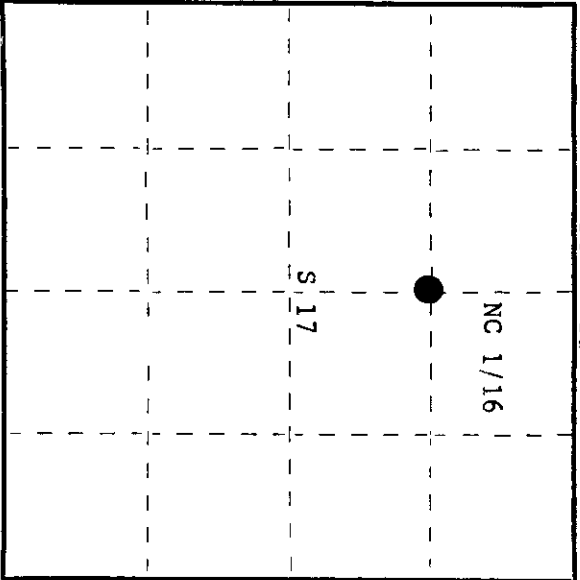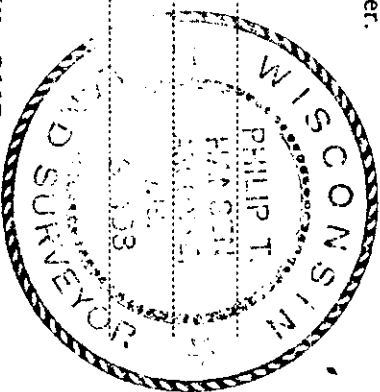

○ = Corner monument restored.

History of original corner establishment:

Corner established by N. Loftus and crew in 1958. Ran N-S and E-W 1/4 line from previously recovered 1/4 corners. Established C 1/4 corner at 43.2525 chains S 8° 58' E of N 1/4 corner. Set NC 1/16 at 21.626 chains intermediate.

Marked NBT's -

Cedar 5" N62°E 82½ links

Cedar 6" S60°E 25½ links

Description of corner evidence found:

Recovered 4" squared cedar post, scribed CN 1/16 S17, CN 1/16 S17, standing in fair condition.

Recovered OBT's -

Cedar 5" (6") N62°E 32.5 links, scribed CN 1/16 S17 BT.

Cedar 6" (7") S60°E 25.5 links, scribed CN 1/16 S17 BT.

Description of monument and accessories I established to perpetuate the original location of this corner.

Replaced cedar post with 1½" iron pipe with 2" diameter brass cap, projecting 24", stamped: No additional accessories established.

S498  
T36N R11E  
NC 1/16 S-17  
CFT-1979

Dated at Rhineland, Wis., this 31st day of January, 1979.

Signature Phillip T. Hansen Title Registered Land Surveyor Registration No. S-498  
(County Surveyor, Registered Land Surveyor, or other duly authorized official)

Office of Register of Deeds, County of Oneida, I hereby certify that the within instrument was filed in this office for record on the 17th day of February, 1979 at 1:30 o'clock P. M.

Dona George Fischer  
(Register of Deeds)

By: \_\_\_\_\_ Deputy

2002071136