

State of Wisconsin

County of Oneida } ss.



I, Phillip T. Hansen, do hereby certify that on the 5th day of January, 1979, I found evidence of the NW 1/16 corner of Section 17 Township 36 North, Range 11 East, Fourth Principal Meridian, as described hereon; and that from this evidence I established a new monument and accessories as described hereon to perpetuate the original location of this corner.

Resident witnesses:

Glen Barker

Jim Claflin

Herb Wagoner

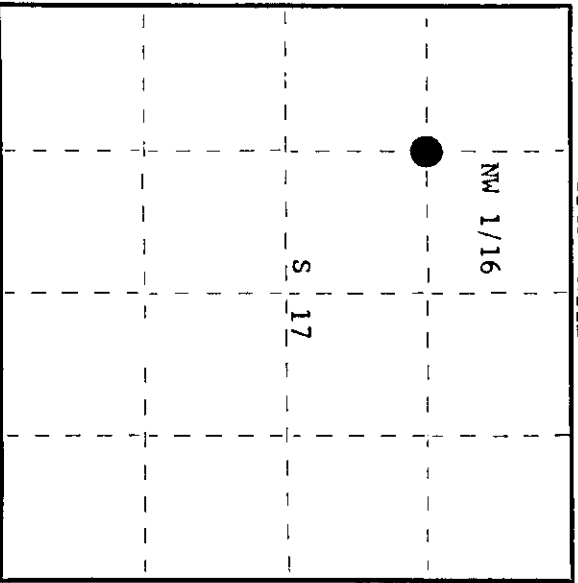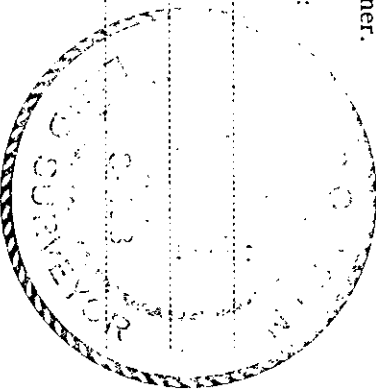

○ = Corner monument restored.

History of original corner establishment:

Corner established by Goddard and crew, Ripco surveyors, in 1958. Ran random line 87° 56' magnetic from N 1/16 corner, west line 40.84 chains to close out 59½ links south of NW 1/16 corner. Set NW 1/16 corner at 20.42 chains 29-3/4 links north. Marked NBT's -
Maple 13" S23°W 21 links
Maple 11" N85°E 43 links
Corrected bearing N 87° 04' E.

Description of corner evidence found:

Unable to recover any corner.
Recovered OBT's -
Maple 13" (16") S23°W 21 links, scribing visible.
Maple 11" (14") N85°E 43 links, scribing visible.

Description of monument and accessories I established to perpetuate the original location of this corner.

Set 1½" iron pipe with 2" brass cap at intersection of calls from recovered BT's.

Cap stamped:

Monument projects 18" above ground.
No additional accessories established.

S498
T36N R11E
NW 1/16 S 17
CPI-1979

Dated at Rhineland, Wis., this 10th day of January, 1979.

Signature Phillip T. Hansen Title Registered Land Surveyor Registration No. S-498
(County Surveyor, Registered Land Surveyor, or other duly authorized official)

Office of Register of Deeds, County of Oneida. I hereby certify that the within instrument was filed in this office for record on the 25th day of January, 1979 at 1:15 o'clock P. M.

Doris Verage Kuehn
(Register of Deeds)

By: _____ Deputy

0 M O N 7 1 1 9 7 9