

CERTIFIED LAND CORNER RESTORATION

Index No. **N-5**

State of Wisconsin } ss.
 County of Oneida

I Phillip T. Hansen do hereby certify that on the 6th day of December 1976, I found evidence of the Section Corner corner of SL7, 18, 19, 20 Township 36 North, Range 11 East, Fourth Principal Meridian, as described hereon; and that from this evidence I established a new monument and accessories as described hereon to perpetuate the original location of this corner.



Resident witnesses:

Glen Barker

Jim Clafin

Herb Wagoner

T36N R11E

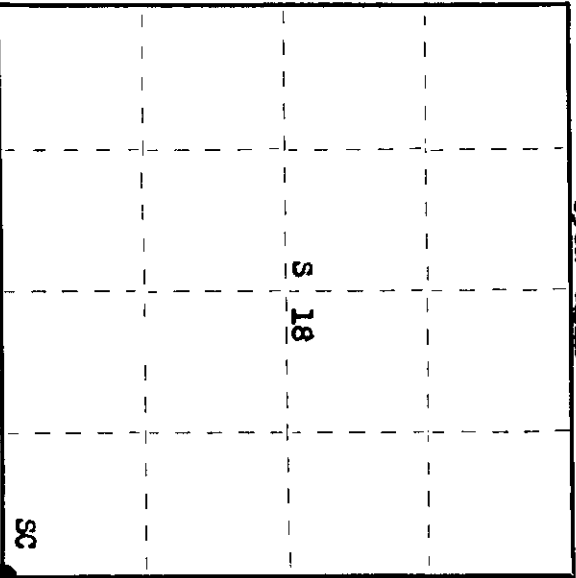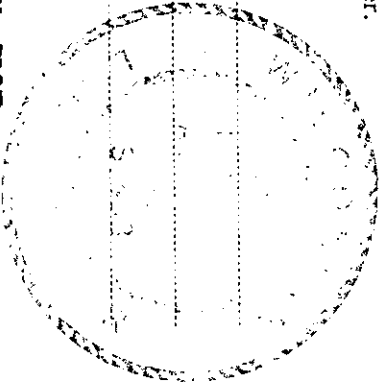

○ = Corner monument restored.

History of original corner establishment:

Original Corner established by Wm. E. Dougherty, Deputy Surveyor, in 1859, from which Tamarack 6" bears N 44° W 8 links and Tamarack 8" bears S 52° E 6 links. Corner recovered by D.H. Vaughan, County Surveyor, in 1900. Set NBTs - Tamarack 7" N 12° E 42 links, Tamarack 7" N 22° W 43 links. Corner recovered by H.C. Lawrence, Registered Land Surveyor. Round two old stakes 78 links apart. Corner in centerline of road, midway between stakes. Marked NBT - Tamarack 7" N 41° E 64 links and Tamarack 9" N 60° W 56 1/2 links.

Description of corner evidence found:

Recovered Lawrence's 4" cedar post, squared and scribed SL7, SL8, SL9, S20 in poor condition.
 Recovered OBTs - Tamarack 7" N 12° E 42 links, now a decayed stump.
 Tamarack 7" N 22° W 43 links, now a decayed mound.
 Tamarack 7" N 41° E 64 links, scribed SL7 NBT, now a 15' stub.
 Tamarack 9" N 60° W 56.5 links, scribed SL8 NBT, now a 20' stub.

Description of monument and accessories I established to perpetuate the original location of this corner.

Replaced 4" cedar post with 2 1/2" iron pipe with brass cap stamped:
 Monument projects 2 1/2 ft. above ground.
 NBTs - Tamarack 6" N 43° E 78.7 links
 Tamarack 8" N 25° E 84.6 links
 Tamarack 6" S 57° W 60.2 links, all scribed SC BT.
 Corner sets in old N-S section line road, now grown up with alders.
 Drove support stakes beside new iron pipe.
 S498
 T36N R11E
 Sec. 18 | 17
 19 | 20
 CPI-1976

Dated at Rhineland, Wis., this 15th day of December, 1976

Signature: Phillip T. Hansen Title: Registered Land Surveyor Registration No. S-498
 County Surveyor, Registered Land Surveyor, or other duly authorized official

Office of Register of Deeds, County of Oneida
 Instrument was filed in this office for record on the 16th day of January, 1977
 at 10:00 o'clock A. M.

Doree Terage Kleber
 Register of Deeds

By Joseph M. Berman Deputy

0000811976