

CERTIFIED LAND CORNER RESTORATION

Index No. N-3

State of Wisconsin

County of Oneida } ss.

I Phillip T. Hansen do hereby

certify that on the 6th day

of December, 1976, I found

evidence of the Quarter

corner of Section 18-19

Township 36 North, Range

11 East, Fourth Principal Meridian,

as described hereon; and that from this evidence

I established a new monument and accessories

as described hereon to perpetuate the original



location of this corner.

Resident witnesses:

Glen Barker

Jim Clark

Herb Wagoner

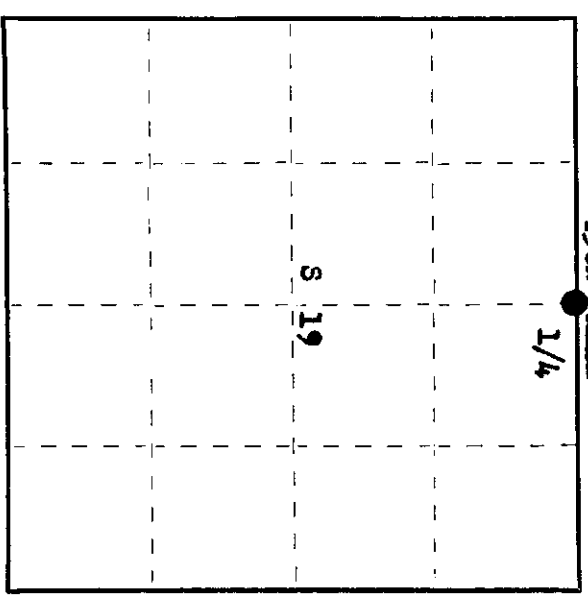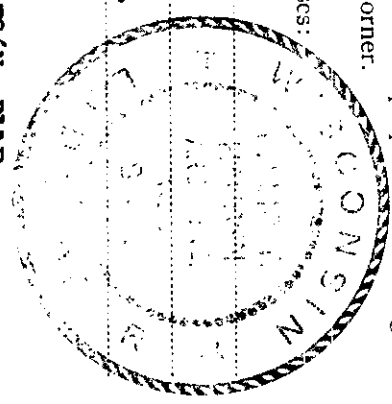

○ = Corner monument restored.

History of original corner establishment:

Original Corner established by Wm. E. Dougherty, Deputy Surveyor, in 1859, from which Tamarack 10" bears N 60° E 13 links, Tamarack 10" bears S 72° W 15 links.

Original Corner recovered by D.H. Vaughan, County Surveyor, in 1904.

Corner recovered by H.C. Lawrence, Registered Land Surveyor, in 1948, recovered stump of original tamarack BT S 72° W 15 links. Dug for and recovered point of original stake.

Set new post and marked NBTs- White Birch 12" S 43° W 32 links
Sugar 6" N 35° W 25 links.

Description of corner evidence found:

Recovered 5" cedar post, squared and scribed 1/4 S S18, 1/4 S S19, in poor condition.
Recovered original Tamarack BT 10" S 72° W (S 76° W) 15 links, now a decayed stump.

A squared cedar post was down in the center of stump. Scribed Original BT.

White Birch 12" S 43° W 32 links, scribed 1/4 S 19, NBT. Now a 25' stub.

Sugar 6" N 55° W 25 links - No evidence of this.

Description of monument and accessories I established to perpetuate the original location of this corner.

Replaced wood post with 2 1/2" Bernitsen A-1 Federal Monument. Cap stamped:

Monument projects 2' above ground.
NBT - Black Spruce 10" N 30° W 51.6 links, scribed 1/4 BT.
Black Spruce 6" S 30° W 30.4 links, scribed 1/4 BT.

Cedar 9" S 69° W 47.5 links, scribed 1/4 BT.

T36N R11E
1/4 S 18
1/4 S 19
S498-1976

Dated at Rhinelander, Wis., this 14th day of December, 1976

Signature Phillip T. Hansen Title Registered Land Surveyor Registration No. S-498
(County Surveyor, Registered Land Surveyor, or other duly authorized official)

Office of Register of Deeds, County of Oneida I hereby certify that the within
instrument was filed in this office for record on the 7th day of February, 1977
at 1:45 o'clock P. M.

Doree Savage Tuck
(Register of Deeds)

By Joseph M. Bremer Deputy