

CERTIFIED LAND CORNER RESTORATION

Index No. N-2

State of Wisconsin

County of Oneida

ss.

I Phillip T. Hansen, do hereby certify that on the 6th day of December, 19 76, I found evidence of the W 1/16 corner of Section 18-19 Township 36, North, Range 11 East, Fourth Principal Meridian,

as described hereon; and that from this evidence I established a new monument and accessories as described hereon to perpetuate the original location of this corner.

Resident witnesses:

Glenn Barker

Jim Craftin

Herb Wagoner

T36N R11E

History of original corner establishment:
 Corner established by D.H. Vaughan, County Surveyor, in 1900. Set post and marked BFs - Fir 10" N 51° W 44½ links and Tamarack 10" S 64½° W 14 links. Corner recovered by H.C. Lawrence, Registered Land Surveyor. Recovered Vaughan's old post and tamarack BF 12" S 45° W 16 links. Set new post and marked NBTs - Cedar 12" S 31° E 32½ links, Cedar 6" N 36° W 32½ links.


Description of corner evidence found:

Recovered Lawrence's 5" cedar post, squared and scribed W 1/16 S18, W 1/16 S19 in fair condition.

Recovered OBT - Tamarack 10" S 64½° W 14 links, now a decayed stump. There is a 4" squared cedar stake in center of it scribed BF.
 Cedar 6" (8") N 36° W 32.5 links, scribed W 1/16 S18 NBT.
 Cedar 12" S 31° E 33.5 links, scribed W 1/16 NBT.

Description of monument and accessories I established to perpetuate the original location of this corner.
 Replaced 5" cedar post with 1½" OD iron pipe with 2" brass cap stamped:
 Monument projects 2½" above ground.
 NBT - Cedar 8" S 67° W 43.2 links, scribed 1/16 BT.

S498
 T36N R11E
 W 1/16 S 18
 S 19
 CPL-1976

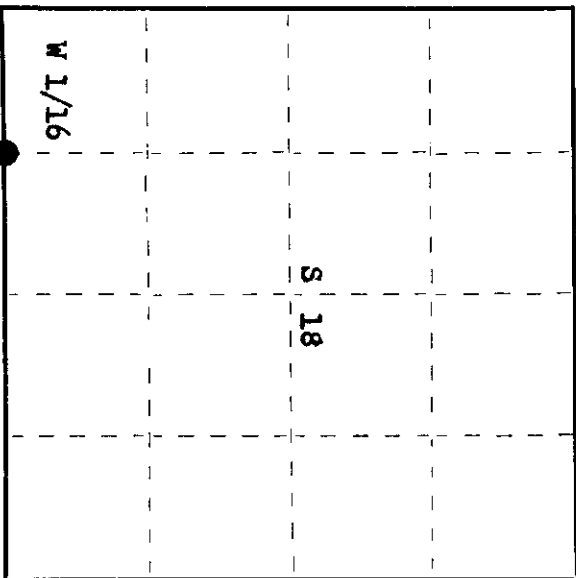

○ = Corner monument restored.

Dated at Rhinelander, Wis., this 15th day of December, 19 76.

Signature: Phillip T. Hansen Title: Registered Land Surveyor Registration No. S-498
 (County Surveyor, Registered Land Surveyor, or other duly authorized official)

Office of Register of Deeds, County of Oneida
 Instrument was filed in this office for record on the 10th day of February, 19 77
 at 10:00 o'clock a. M.

Doris Vantage Kuehn
 (Register of Deeds)

By Joseph M. Bremer Deputy

361180030