

CERTIFIED LAND CORNER RESTORATION

Index No. W-5

State of Wisconsin

County of Oneida } ss.



I, Phillip T. Hansen, do hereby certify that on the 5th day of January, 1979, I found evidence of the S 1/16 corner of Section 17 and 18 Township 36, North, Range 11 East, Fourth Principal Meridian, as described hereon; and that from this evidence I established a new monument and accessories as described hereon to perpetuate the original location of this corner.

Resident witnesses:

G. Barker

Jim Clafflin

Herb Wagoner

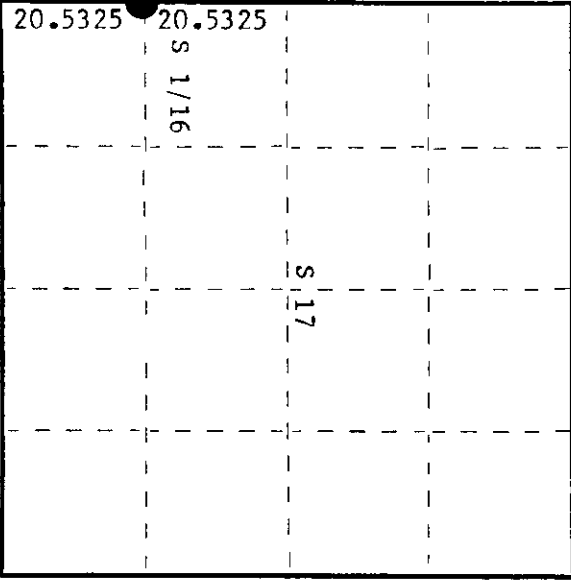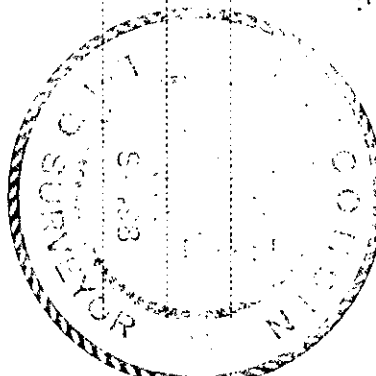

History of original corner establishment:

Corner established by Goddard and crew, Ripco surveyors, in 1958. Ran random line south from section corner 7, 8, 17 and 18, bearing 172° 14' magnetic 82.13 chains to close out 24 1/2 links east of section corner. Established S 1/16 corner at 61.5975 chains - 18.1875 links west. Marked NBT's - Balsam 8" S50°E 37 links R. Maple 3" S79°W 45-3/4 links Corrected bearing S 7° 36' E.

Description of corner evidence found:

Recovered 3/4" iron pipe with 2" square brass cap in good condition, projecting 18" above ground. Cap stamped:
Recovered OBT's -
Balsam 8" S50°E 37 links (37.3 links), now a 10' stub.
Maple 3" S79°W 45-3/4 links, scribbling grown over.

RIFCO

Description of monument and accessories I established to perpetuate the original location of this corner.
Monument left in place as recovered.
Marked NBT - Maple 8" N36°E 69 links, scribed 1/16 BT.

Dated at Rhineland, Wis., this 10th day of January, 1979.

Signature Phillip T. Hansen Title Registered Land Surveyor Registration No. S-498
(County Surveyor, Registered Land Surveyor, or other duly authorized official)

Office of Register of Deeds, County of Oneida
Instrument was filed in this office for record on the 25th day of January, 1979
at 1/5 o'clock P. M.

Dorcas Venage Kuehn
(Register of Deeds)

By: _____ Deputy