

CERTIFIED LAND CORNER RESTORATION

Index No. L-5

State of Wisconsin

County of Oneida } ss.



I, Phillip T. Hansen, do hereby certify that on the 5th day of January, 1979, I found evidence of the Quarter corner of Section 17 & 18 Township 36, North, Range 11 East, Fourth Principal Meridian, as described hereon; and that from this evidence I established a new monument and accessories as described hereon to perpetuate the original location of this corner.

Resident witnesses:

Glen Barker

Jim Clafflin

Herb Wagoner

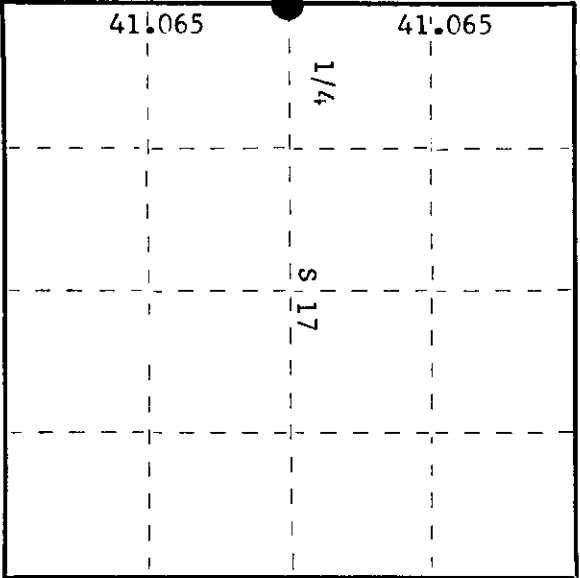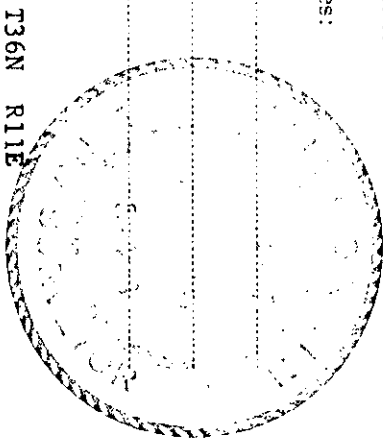

O = Corner monument restored.

CERTIFIED LAND CORNER RESTORATION

History of original corner establishment:

Original corner established by Wm. E. Dougherty, Deputy Surveyor, in 1859 from which tamarack 10" bears N 41° W, 12 links and tamarack 8" bears S 83° E, 11 links.

Corner established by Goddard and crew, Ripco surveyors, in 1958. Ran random line south bearing 172° 14' magnetic from section corner 7, 8, 17 and 18, 82.13 chains to close out 24 1/4 links east of section corner. Set 1/4 corner at 41.065 chains, 12.125 links west. Marked NBT's - Balsam 3" S56°E 20 links Aspen 5" N78°W 3 links

Corrected bearing S 7° 36' E.

Description of corner evidence found:

Recovered 2" iron pipe with 3" square brass cap in good condition, projecting 24" above ground. Cap stamped:

Recovered OBT's - Balsam 3" (6") S56°E 20 links (19.7 links). Aspen 5" N78°W 3 links, now a rotted stump.

T36N R11E
1/4
S18 + S17
RIPCO

Description of monument and accessories I established to perpetuate the original location of this corner.

Left monument in place as recovered.

Marked NBT's -

- Maple 10" N77°E 62.6 links
 - Maple 5" S58°E 42.1 links
 - Maple 5" S37°W 68.3 links
 - W. Birch 8" N52°W 78.8 links
- all scribed 1/16 BT.

Dated at Rhineland, Wis., this 10th day of January, 1979

Signature Phillip T. Hansen Title Registered Land Surveyor Registration No. S-498
(County Surveyor, Registered Land Surveyor, or other duly authorized official)

Office of Register of Deeds, County of Oneida 35th day of January, 1979
at 1:30 o'clock P. M. I hereby certify that the within

Dennis George Kuehn
(Register of Deeds)

By: _____ Deputy

00078811193