

CERTIFIED LAND CORNER RESTORATION

Index No. P-5

State of Wisconsin

County of Oneida } ss.

I Phillip T. Hansen 3rd, do hereby

certify that on the 3rd day

of May, 1979, I found

evidence of the Quarter

corner of Section 19 and 20

Township 36, North, Range


11 East, Fourth Principal Meridian,

as described hereon; and that from this evidence

I established a new monument and accessories

as described hereon to perpetuate the original

location of this corner.

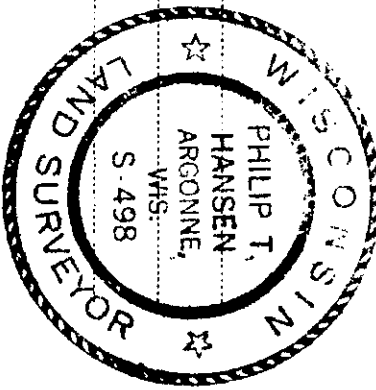


History of original corner establishment:
 Original corner established by Wm. E. Dougherty, Deputy Surveyor, in 1859. Notes on Vaughan's plat of 1900 and 1904 indicate that he recovered the corner. Marked 10" Birch N 40-1/2° E 40 links and Hemlock 8" S 72-1/2° W 41-1/2 links. These were found by H.C. Lawrence, Registered Land Surveyor, but the trees were reversed. Corner is in line with old E-W fence line in sections 19 and 20. N. Loftus started at this corner in 1958 to run the E-W 1/4 line. Found an old 1/2" iron bolt buried in the road bed.

Description of corner evidence found:
 Recovered the old 1/2" iron bolt in center of road, buried 4" below the surface. Also recovered an old 2 1/2" iron pipe with brass cap, not stamped, 51 feet due east of the iron bolt. Bolt is in line with the old E-W fence line running west in section 19 and east in section 20.

Description of monument and accessories I established to perpetuate the original location of this corner.
 Replaced 1/2" bolt with 1-1/2" x 18" iron pipe, buried 6" below surface. Used the old 2-1/2" iron pipe 51' east for witness corner. Stamped:

This witness corner monument projects 24".
 Marked NBT's from true corner,
 Maple 6" N39°E 36.10 feet, scribed 1/4 BT
 Hemlock 10" S63°E 36.81 feet, scribed 1/4 BT
 Maple 5" S31°W 44.90 feet, scribed 1/4 BT
 S498
 T36N R11E
 1/4 S19 S20 W.C.
 W - 51 ft.
 CPI-1979

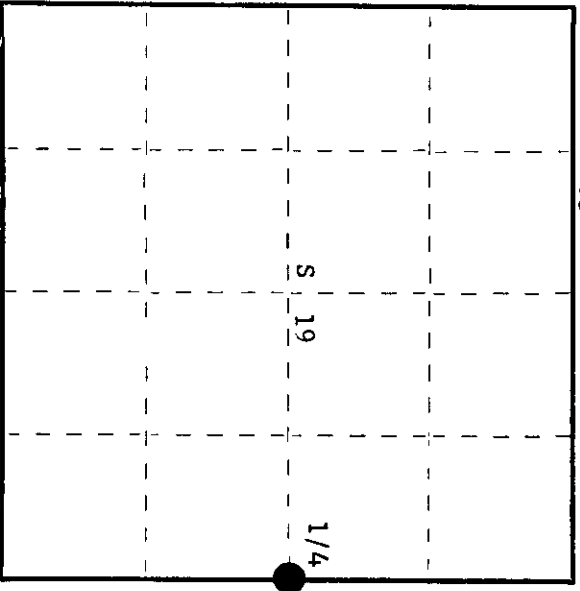

○ = Corner monument restored.

Dated at Rhinelander, Wis., this 7th day of May, 1979.

Signature Phillip T. Hansen, Title Registered Land Surveyor, Registration No. S-498
(County Surveyor, Registered Land Surveyor, or other duly authorized official)

Office of Register of Deeds, County of Oneida, I hereby certify that the within instrument was filed in this office for record on the 17th day of May, 1979 at 1:30 o'clock P. M.

Eric Verage Ancher
(Register of Deeds)

By: _____ Deputy

361192000