

CERTIFIED LAND CORNER RESTORATION



Index No. **R-9**

State of Wisconsin

County of Oneida } ss.

I, Philip T. Hansen, do hereby certify that on the 17th day of June, 1975, I found evidence of the Section Corner corner of Sections 20, 21, 28, & 29 Township 36, North, Range 11 East, Fourth Principal Meridian, as described hereon; and that from this evidence I established a new monument and accessories as described hereon to perpetuate the original location of this corner.

Resident witnesses:

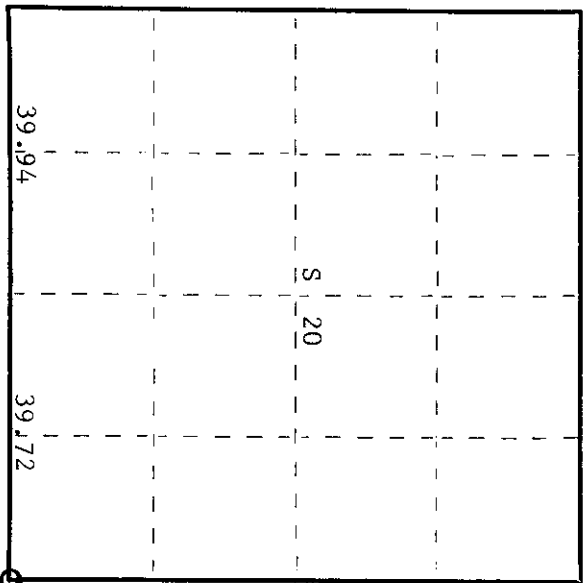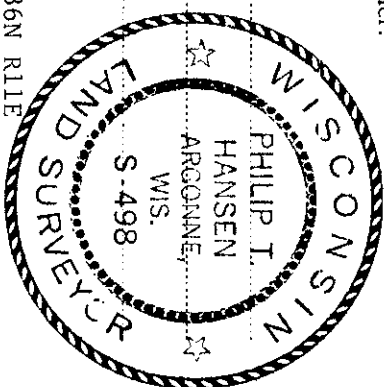

○ = Corner monument restored.

History of original corner establishment:

Original corner established by Wm. E. Dougherty, Gov. Deputy Surveyor, in 1859, from which white pine 10" bears S56°E 32 links, and white pine 10" bears S57°W 7 links. Corner re-covered by B.F. Dorr, County Surveyor. D.H. Vaughan, County Surveyor, surveyed the line between Sections 20 and 29 for a road in 1915. However, the notes for this survey will be found under Sec. 20-35-11, an apparent error on his part. He found post set by Dorr, the original trees nearly gone, corner recovered by H.C. Lawrence, Registered Land Surveyor. Found an iron pipe set flush with ground in line with fences N, S, and E. This iron pipe is S3°E 41½ links from new high fence post and N87°E 50 links from another fence post.

Description of corner evidence found:

Corner recovered, 1" iron pipe buried in road bed, from Lawrence's measurements to fence posts.

Recovered OBT - someone's red pine 13" N84°E 101.3 links, scribed BT.

Description of monument and accessories I established to perpetuate the original location of this corner.

Set new witness corner, 2½" iron pipe with brass cap stamped - S498 a distance of 65 links east of iron pipe.

NBT's - red pine 12" N46°E 82 links, scribed SC BT. T36N R11E  
 Highline pole #3611-29E8 S58°W 70.6 links. S20 | S21 W.C.  
 These are referenced to true corner. S29 | S28  
 W 65 links

CPI-1975

Dated at Rhineland, Wis., this 10th day of July, 1975.

Signature Philip T. Hansen Title Registered Land Surveyor Registration No. S-498  
 (County Surveyor, Registered Land Surveyor, or other duly authorized official)

Office of Registrar of Deeds, County of Oneida  
 instrument was filed in this office for record on the 1st day of October, 1975  
 at 3:00 o'clock P. M.

Doris George Tucker  
 (Registrar of Deeds)

By: \_\_\_\_\_ Deputy

361120000